


TWP 38 S RANGE 7 W.

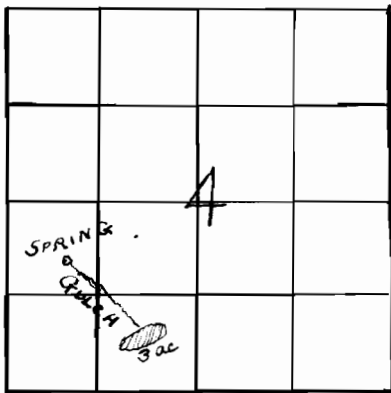

5715
3502