


Permit: S 35020
Volume: 1
Strm: ROGUE R
Trib: PACIFIC OCEAN
Priority: 3/23/70

T.35S.R.7W.W.M.

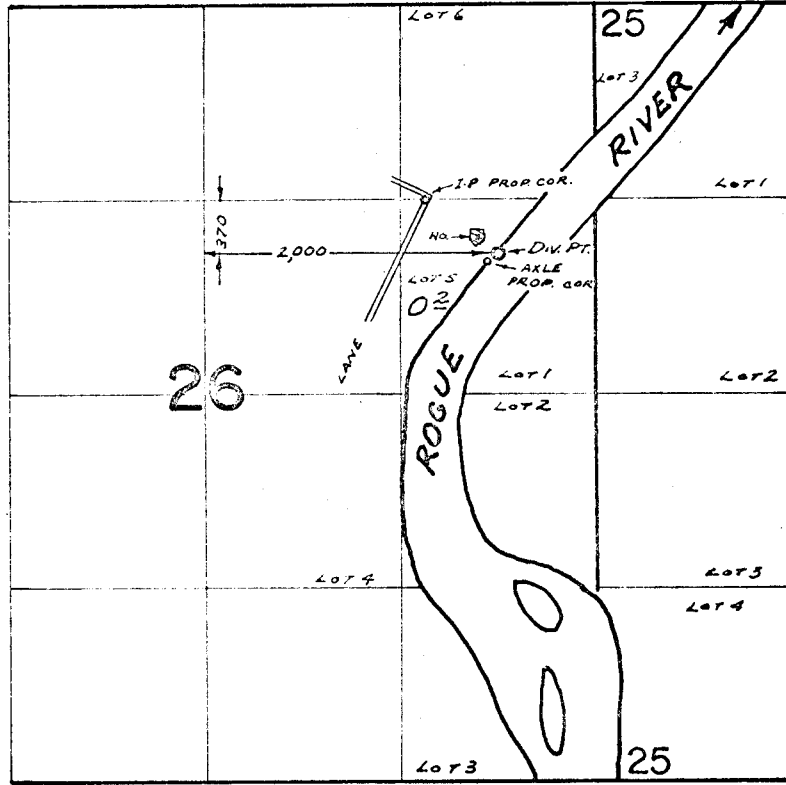

FINAL PROOF SURVEY UNDER

Application No. 46832 Permit No. 35020
IN NAME OF

LESTER A. ROSS

Surveyed APR. 18, 1972, by R. MUCKEN