

I, Geo. E. Tonney, of Myrtle Point, Oregon, do hereby certify that this map was made from notes taken during an actual survey made by me on September 5th., 1917, and that it correctly represents the works described in the accompanying application together with the location of streams and other ditches in the immediate vicinity.


*Geo. E. Tonney*  
 Surveyor.

Copy - Field notes.

- Sta. 0 to 1 - S. 69° 30' E. 103.5'
- 1 " 2 - S. 72° 00' E. 139'
- 2 " 3 - S. 84° 00' E. 183'
- 3 " 4 - S. 41° 00' E. 356'
- 4 " 5 - S. 39° 00' E. 358'
- 5 " 6 - S. 69° 30' E. 860 ±

Sta. 0 - Spring - diversion  
 Sta. 5 - On sec. line 305 ft ±  
 S. of the N.E. 1/4 Cor of Sec. 18  
 Sta. 6 - Place of use of water.

T. 29 S., R. 12 W. Coos Co. Ore

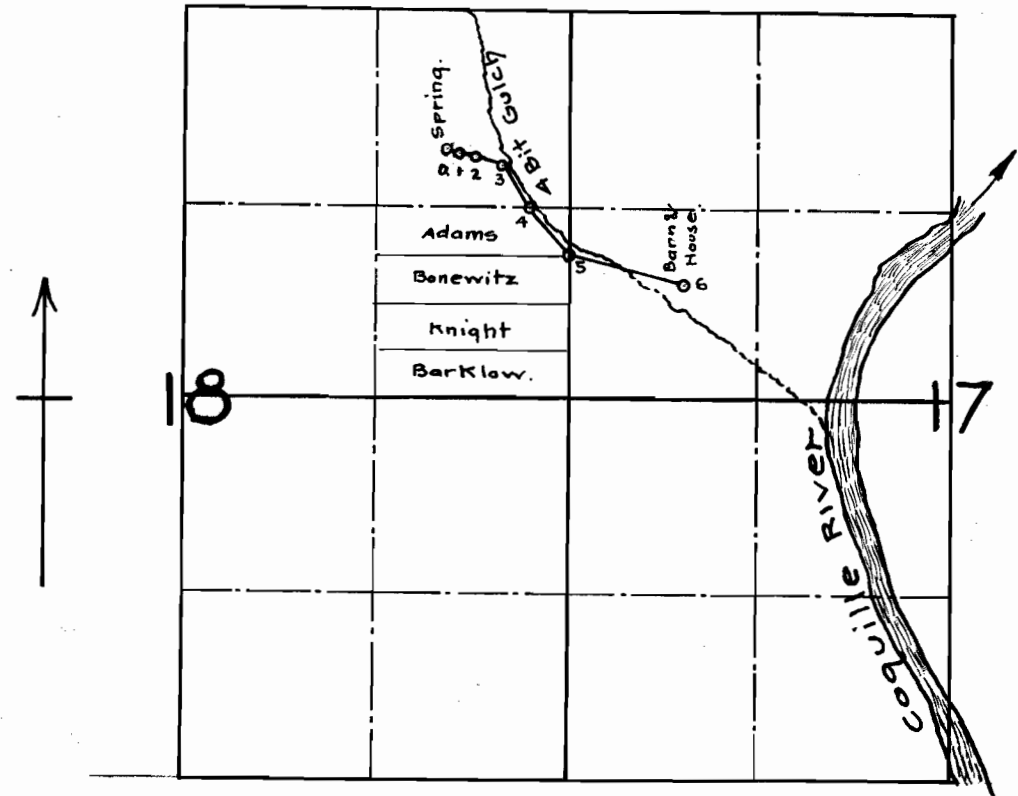

5732  
 3510

Map  
 Accompanying application for permit  
 to appropriate water.  
 for W. R. Davidson  
 Sept. 5th. 1917. Scale - 4 in = 1 mi.