

R15W

RECEIVED

JUL 23 1970


STATE ENGINEER
SALEM, OREGON

30 | 29
31 | 32

11320' West

2640' North

1" iron pipe set at r/w junction; 1/16 corner, NW corner of NESW Sec. 32

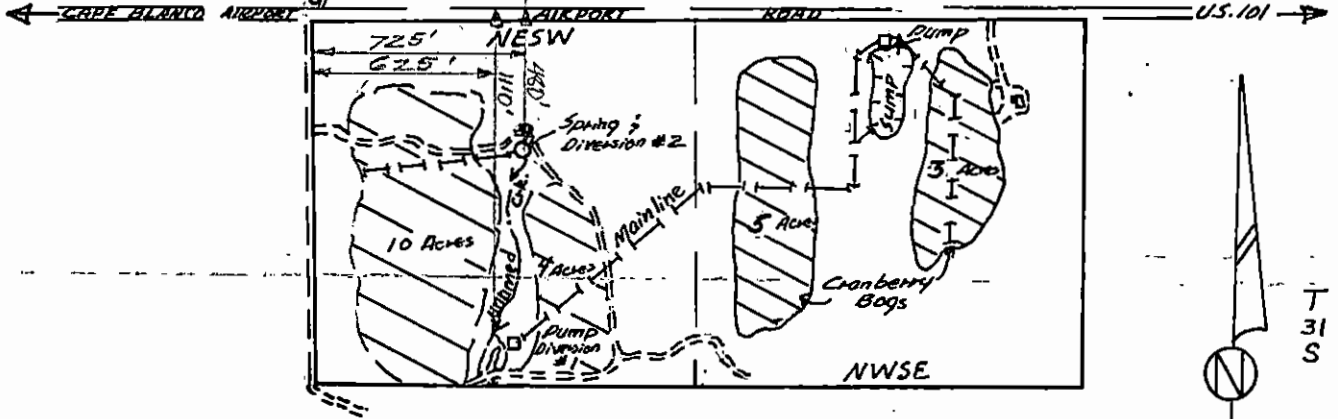

WATER RIGHT LOCATION
 ALBERT W. MOORE
 SIXES, OREGON
 SCALE: 1" = 660'
 MAY 20, 1970

Application No. 47013
 Permit No. 35172

RECEIVED

OCT 15 1970

STATE ENGINEER
SALEM, OREGON