


TOWNSHIP PLAT.

TOWNSHIP No. 1 n. RANGE No. 39 E. W. MER.

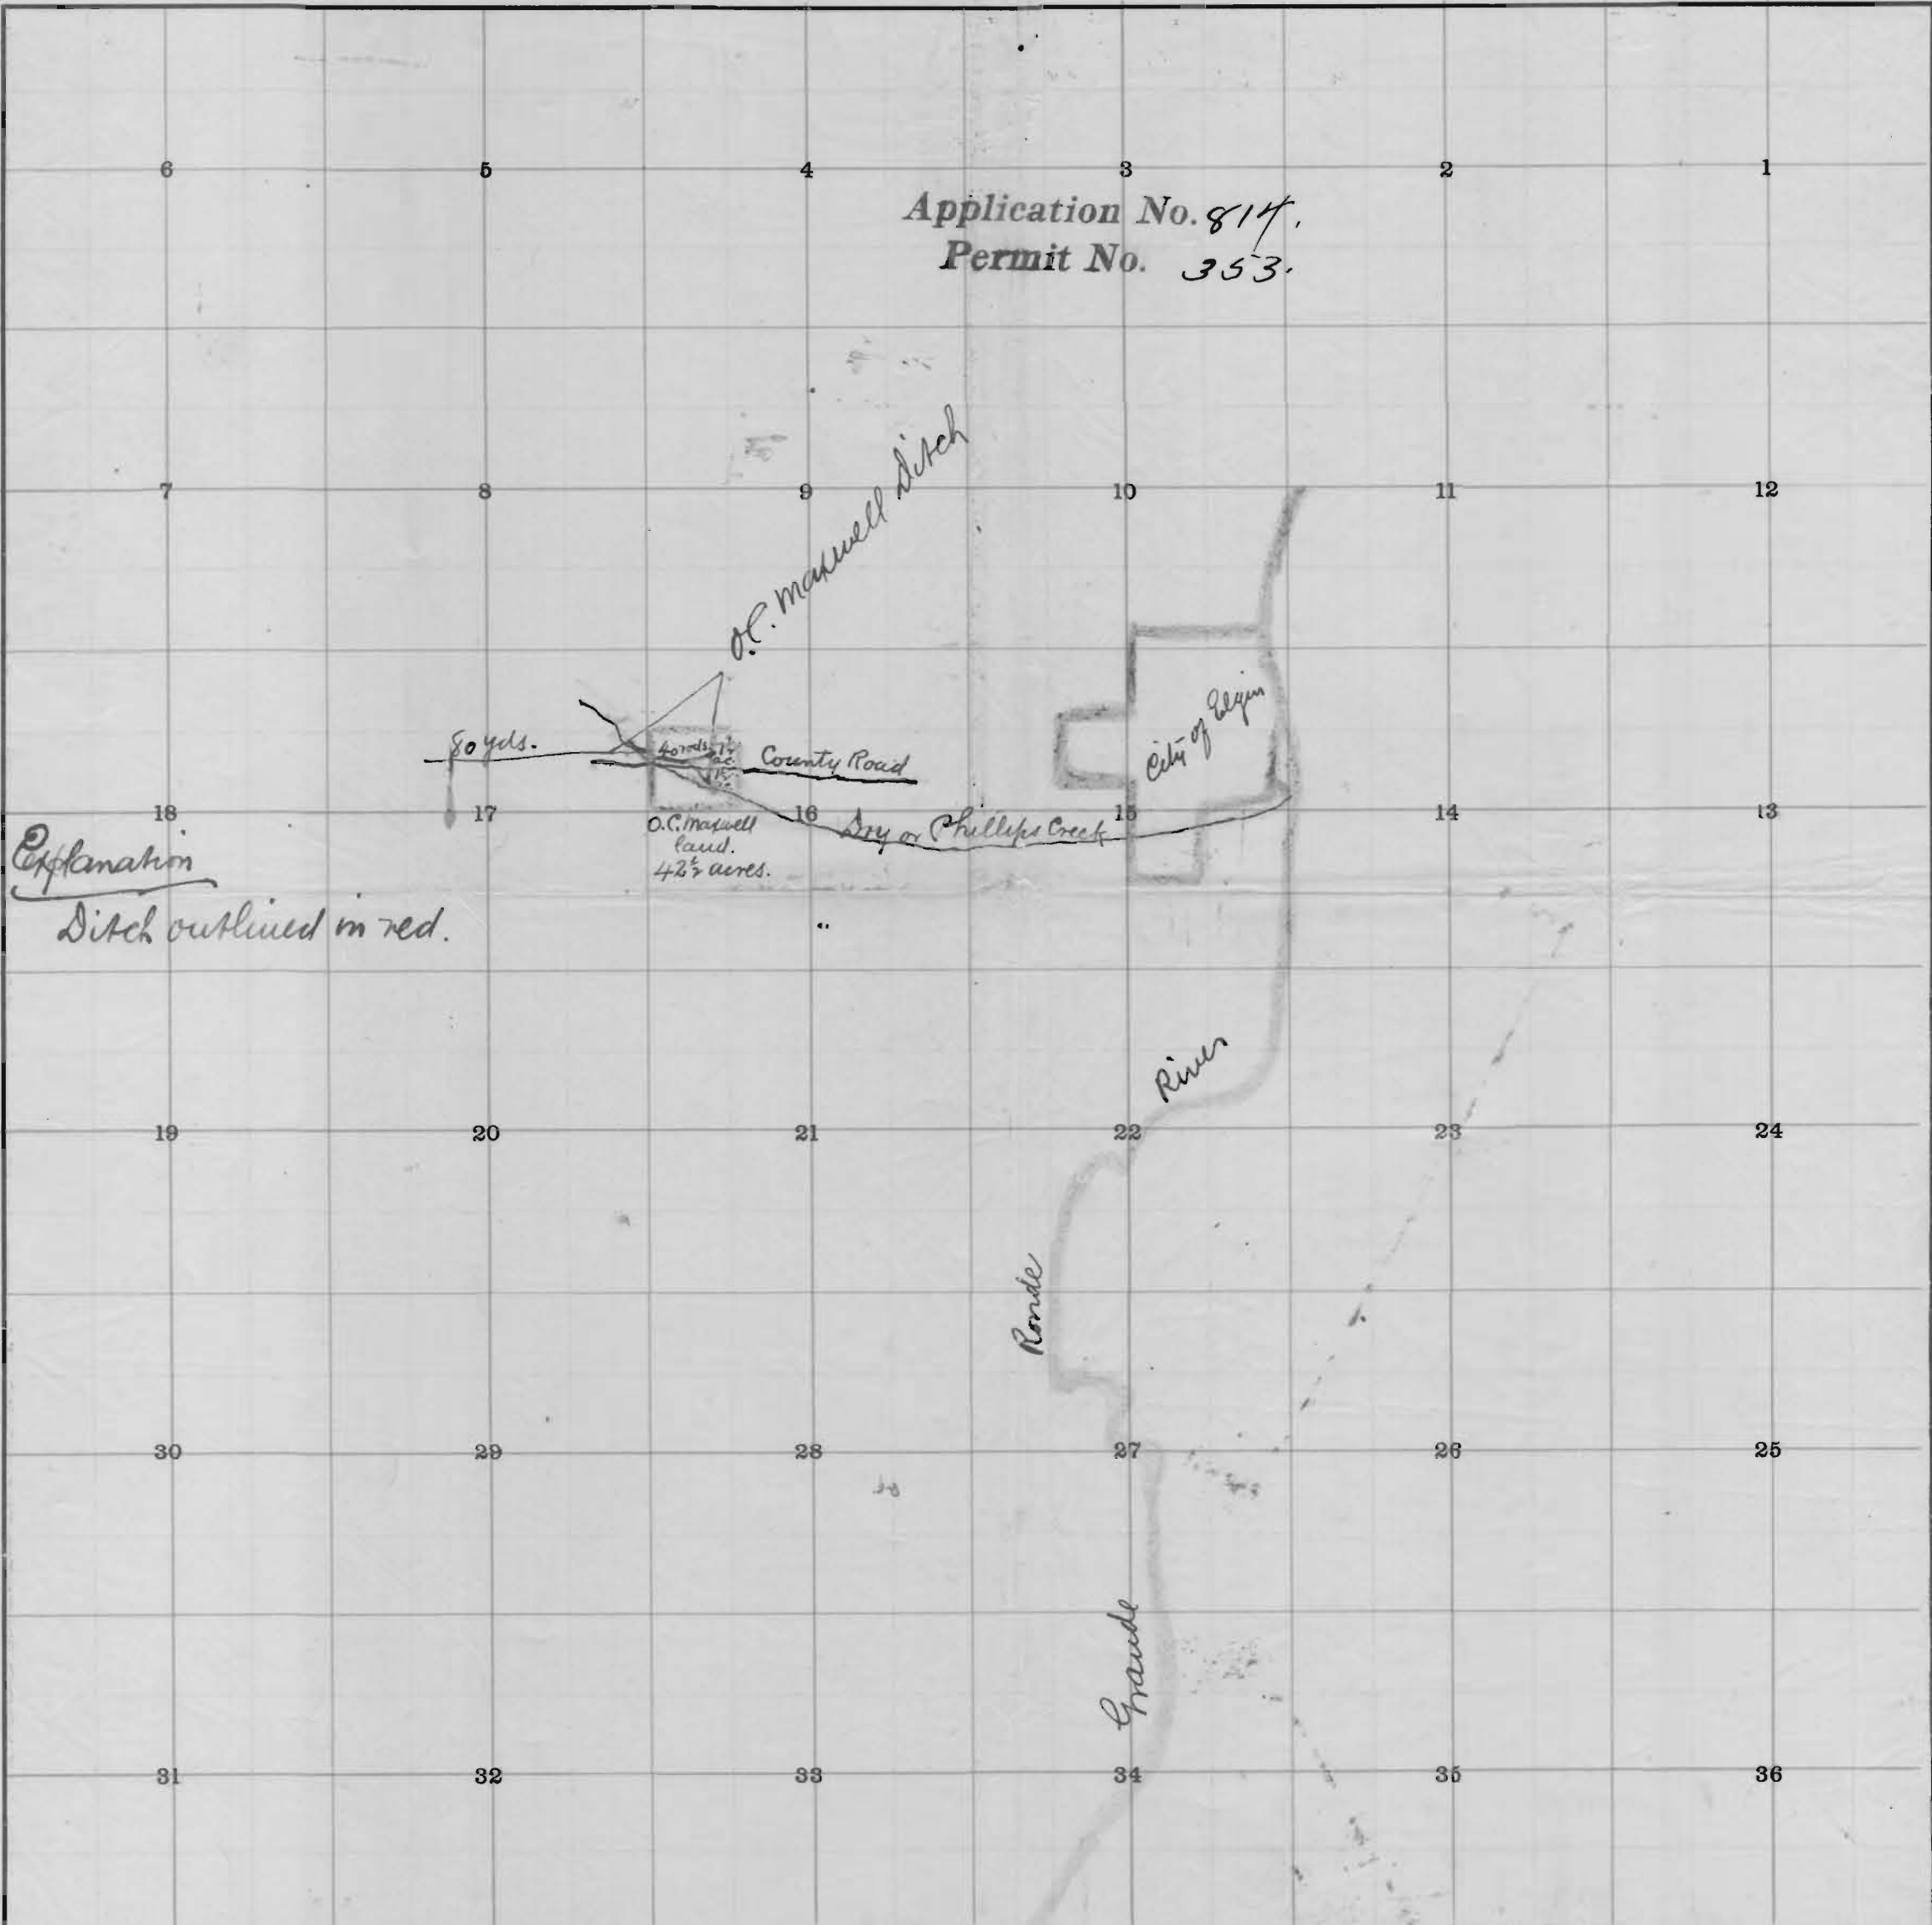

Explanation
Ditch outlined in red.