

35337 15


33-5-7

RECEIVED

JUN 10 1972

STATE ENGINEER
SALEM, OREGON

T.33S.R.5W.W.M.

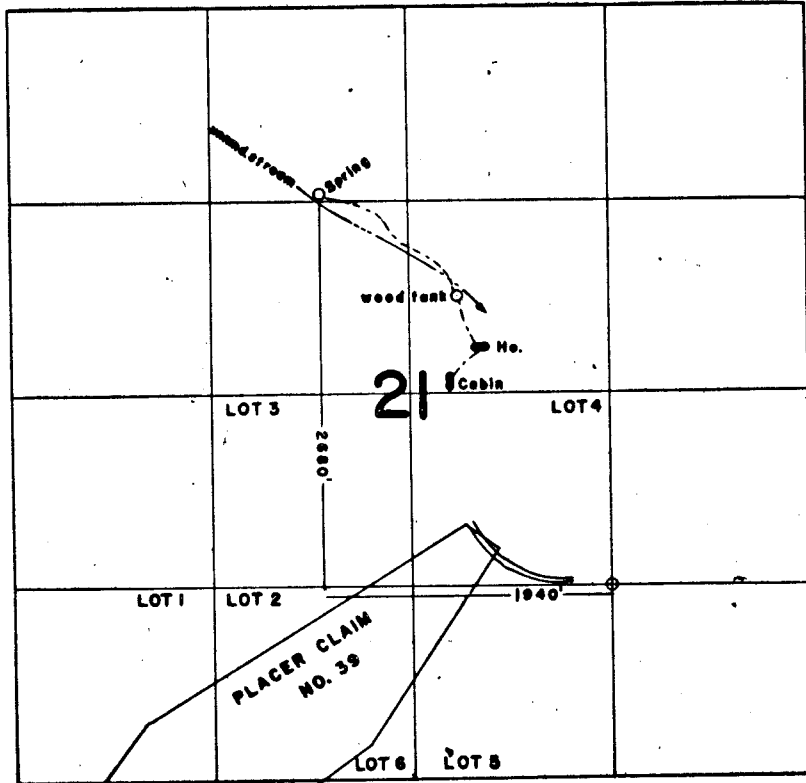

FINAL PROOF SURVEY
UNDER

Application No. 48358... Permit No. 35337....
IN NAME OF

MR. & MRS. W. J. DILLON

Surveyed JUNE 7... 1972, by R.B. STEIMER..