


**RECEIVED**  
JUL 22 1970  
STATE ENGINEER  
SALEM, OREGON

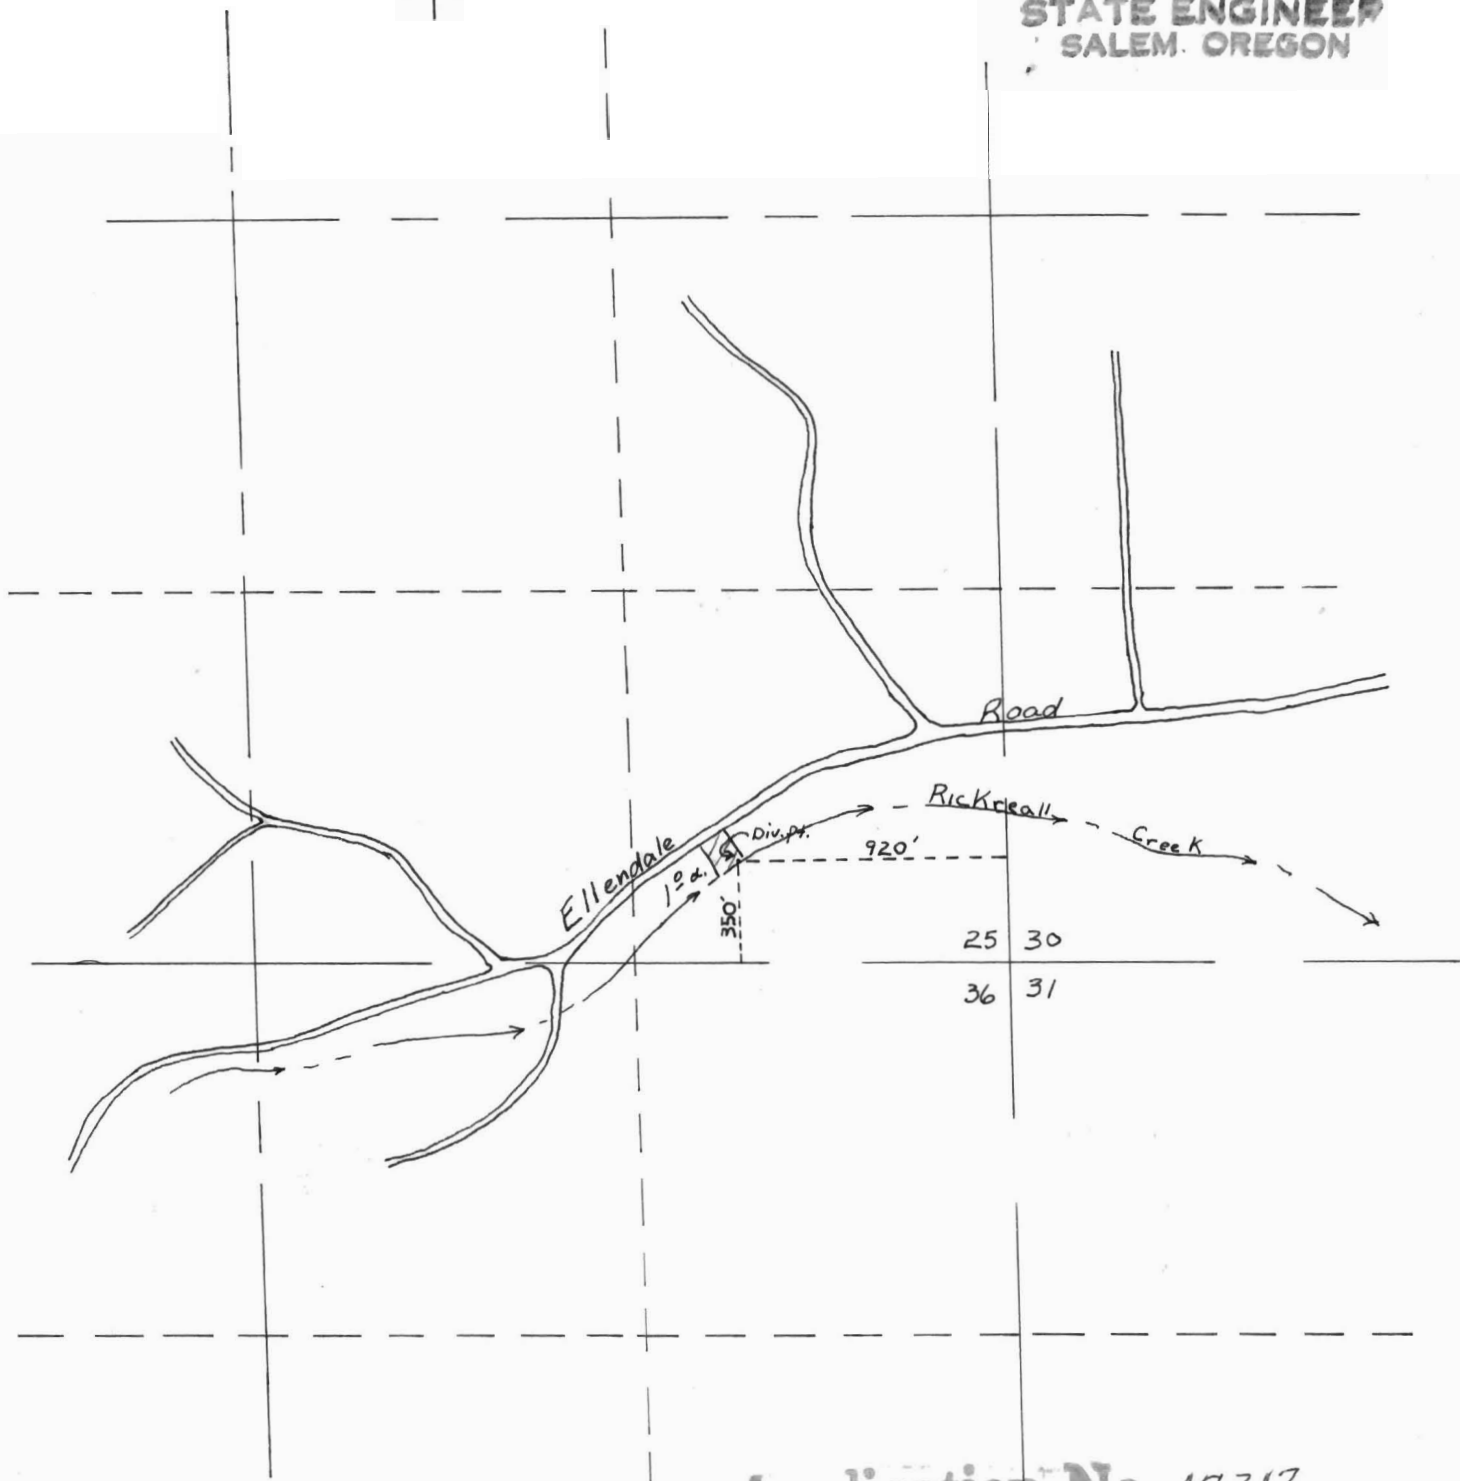

Application No. 47247  
Permit No. 35390

EE. Lossett  
T7S, R6W, Sec 25  
Scale 1" = 660'