


35430

T.35 S. R.6 W. W.M.

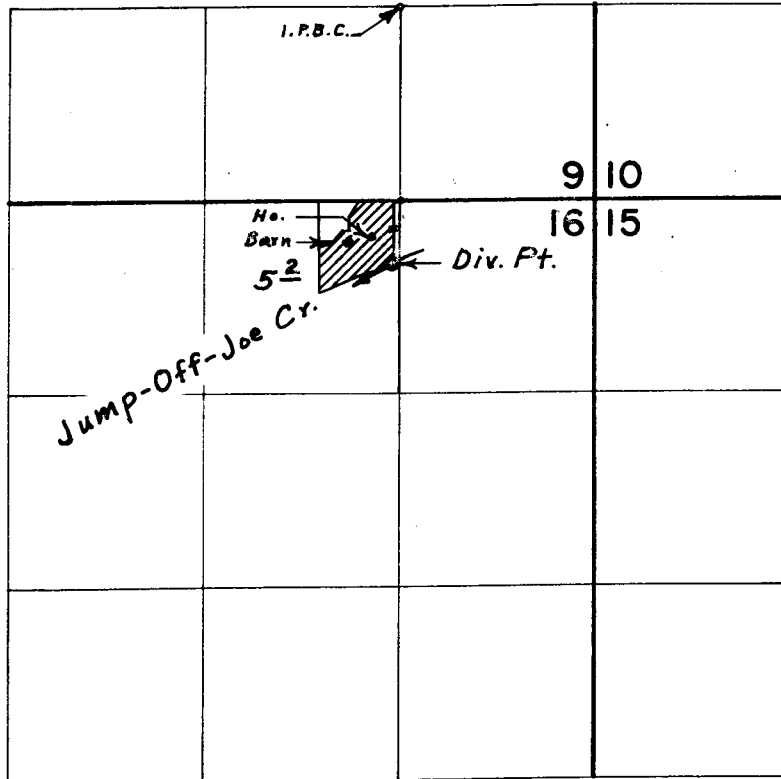

Div. Pt. loc. 1760' S. & 40' W. from N.E. Cor. S.W. $\frac{1}{4}$ S.E. $\frac{1}{4}$ Sec. 9

FINAL PROOF SURVEY
UNDER

Application No. 47266 Permit No. 35430
IN NAME OF

FRANK M. RAY

Surveyed April 4, 1975, by L. E. Gould