

35476


T.36S. R.5W. W.M.

RECEIVED

NOV 24 1976

WM. DIST. 14
GRANTS PASS, ORE.

36-5-20

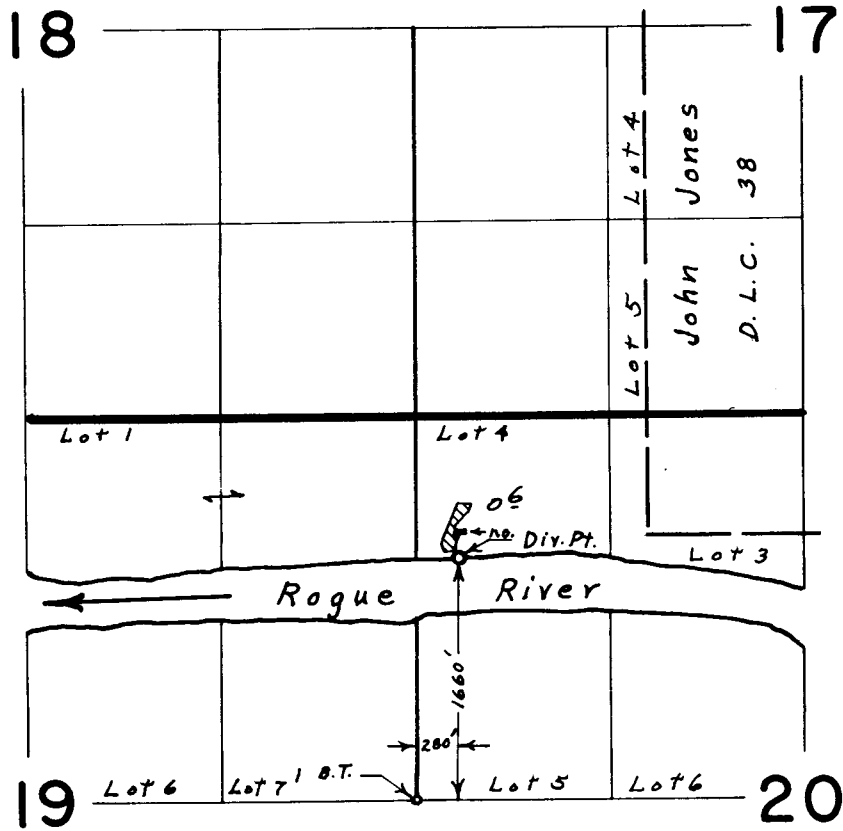

FINAL PROOF SURVEY
UNDER

Application No. 47362 Permit No. 35476
IN NAME OF

JOHN NYLUND

Surveyed April 23, 1974, by L. E. Gould