

RECEIVED  
OCT 23 1970  
STATE ENGINEER  
SALEM, OREGON

*Am. Russell*  
Coke

# ERHART ACRES

Approved this 26th day of October 1914 by

<u>Stelmus Thompson</u>	County Judge
<u>R. H. Humphill</u>	County Commissioner
<u>Ed. M. Lawley</u>	County Commissioner
<u>Benjamin S. Keeney</u>	County Assessor
<u>Hollis W. Libby</u>	County Surveyor

## DESCRIPTION

Beginning at the initial point which is the north west corner of the plat, thence S 086°56' E 20.89 Chs. thence S 01°38' E 19.86 Chs. thence N 087°20' W 22.00 Chs. to shore of Lake, thence Northerly along shore of Lake to point of beginning.  
Note: all distances in chains and links.

## CERTIFICATE

State of Oregon } ss  
County of Lane }

I, James W. Ford, Jr. being first duly sworn, depose and say that I am a surveyor of Florence, Oregon, and that I have correctly surveyed and marked with proper monuments the lands represented on the plat of ERHART ACRES, Lane County, Oregon, and that I planted for the Initial Point of such survey a galvanized iron pipe 2" in diameter and 3' long, driven 6" below the surface of the ground, said point being the Section Corner to Sections 23, 24, 25 and 26 Twp. 19 S., Rge. 12 W., of Will. Mer.

Subscribed and sworn before me this 26th day of October 1914

James W. Ford, Jr.

Ed. T. ...

Notary Public

## DEDICATION

Wm. Erhart Single owner in fee simple, hereby lay out and establish the blocks and lots shown on the plat of ERHART ACRES, Lane County, Oregon, and dedicate to the public the streets and beach indicated thereon to be used as such forever.  
Witness our hands and seals this 26th day of October, 1914

William E. ... Seal

Seal

Done in the presence of

Wm. ...  
Ed. T. ...

## ACKNOWLEDGMENT

State of Oregon } ss  
County of Lane }

On this 26th day of October 1914 personally came before me the undersigned, a Notary Public in and for said County and State, the above mentioned William E. Erhart to me personally known to be identical person described in and who executed the above instrument and acknowledged to me that he executed the same freely and voluntarily for the uses and purposes therein named.


Witness my hand and seal this 26th day of October 1914

Ed. T. ...

Notary Public

Application No. 47668

Permit No. 35604

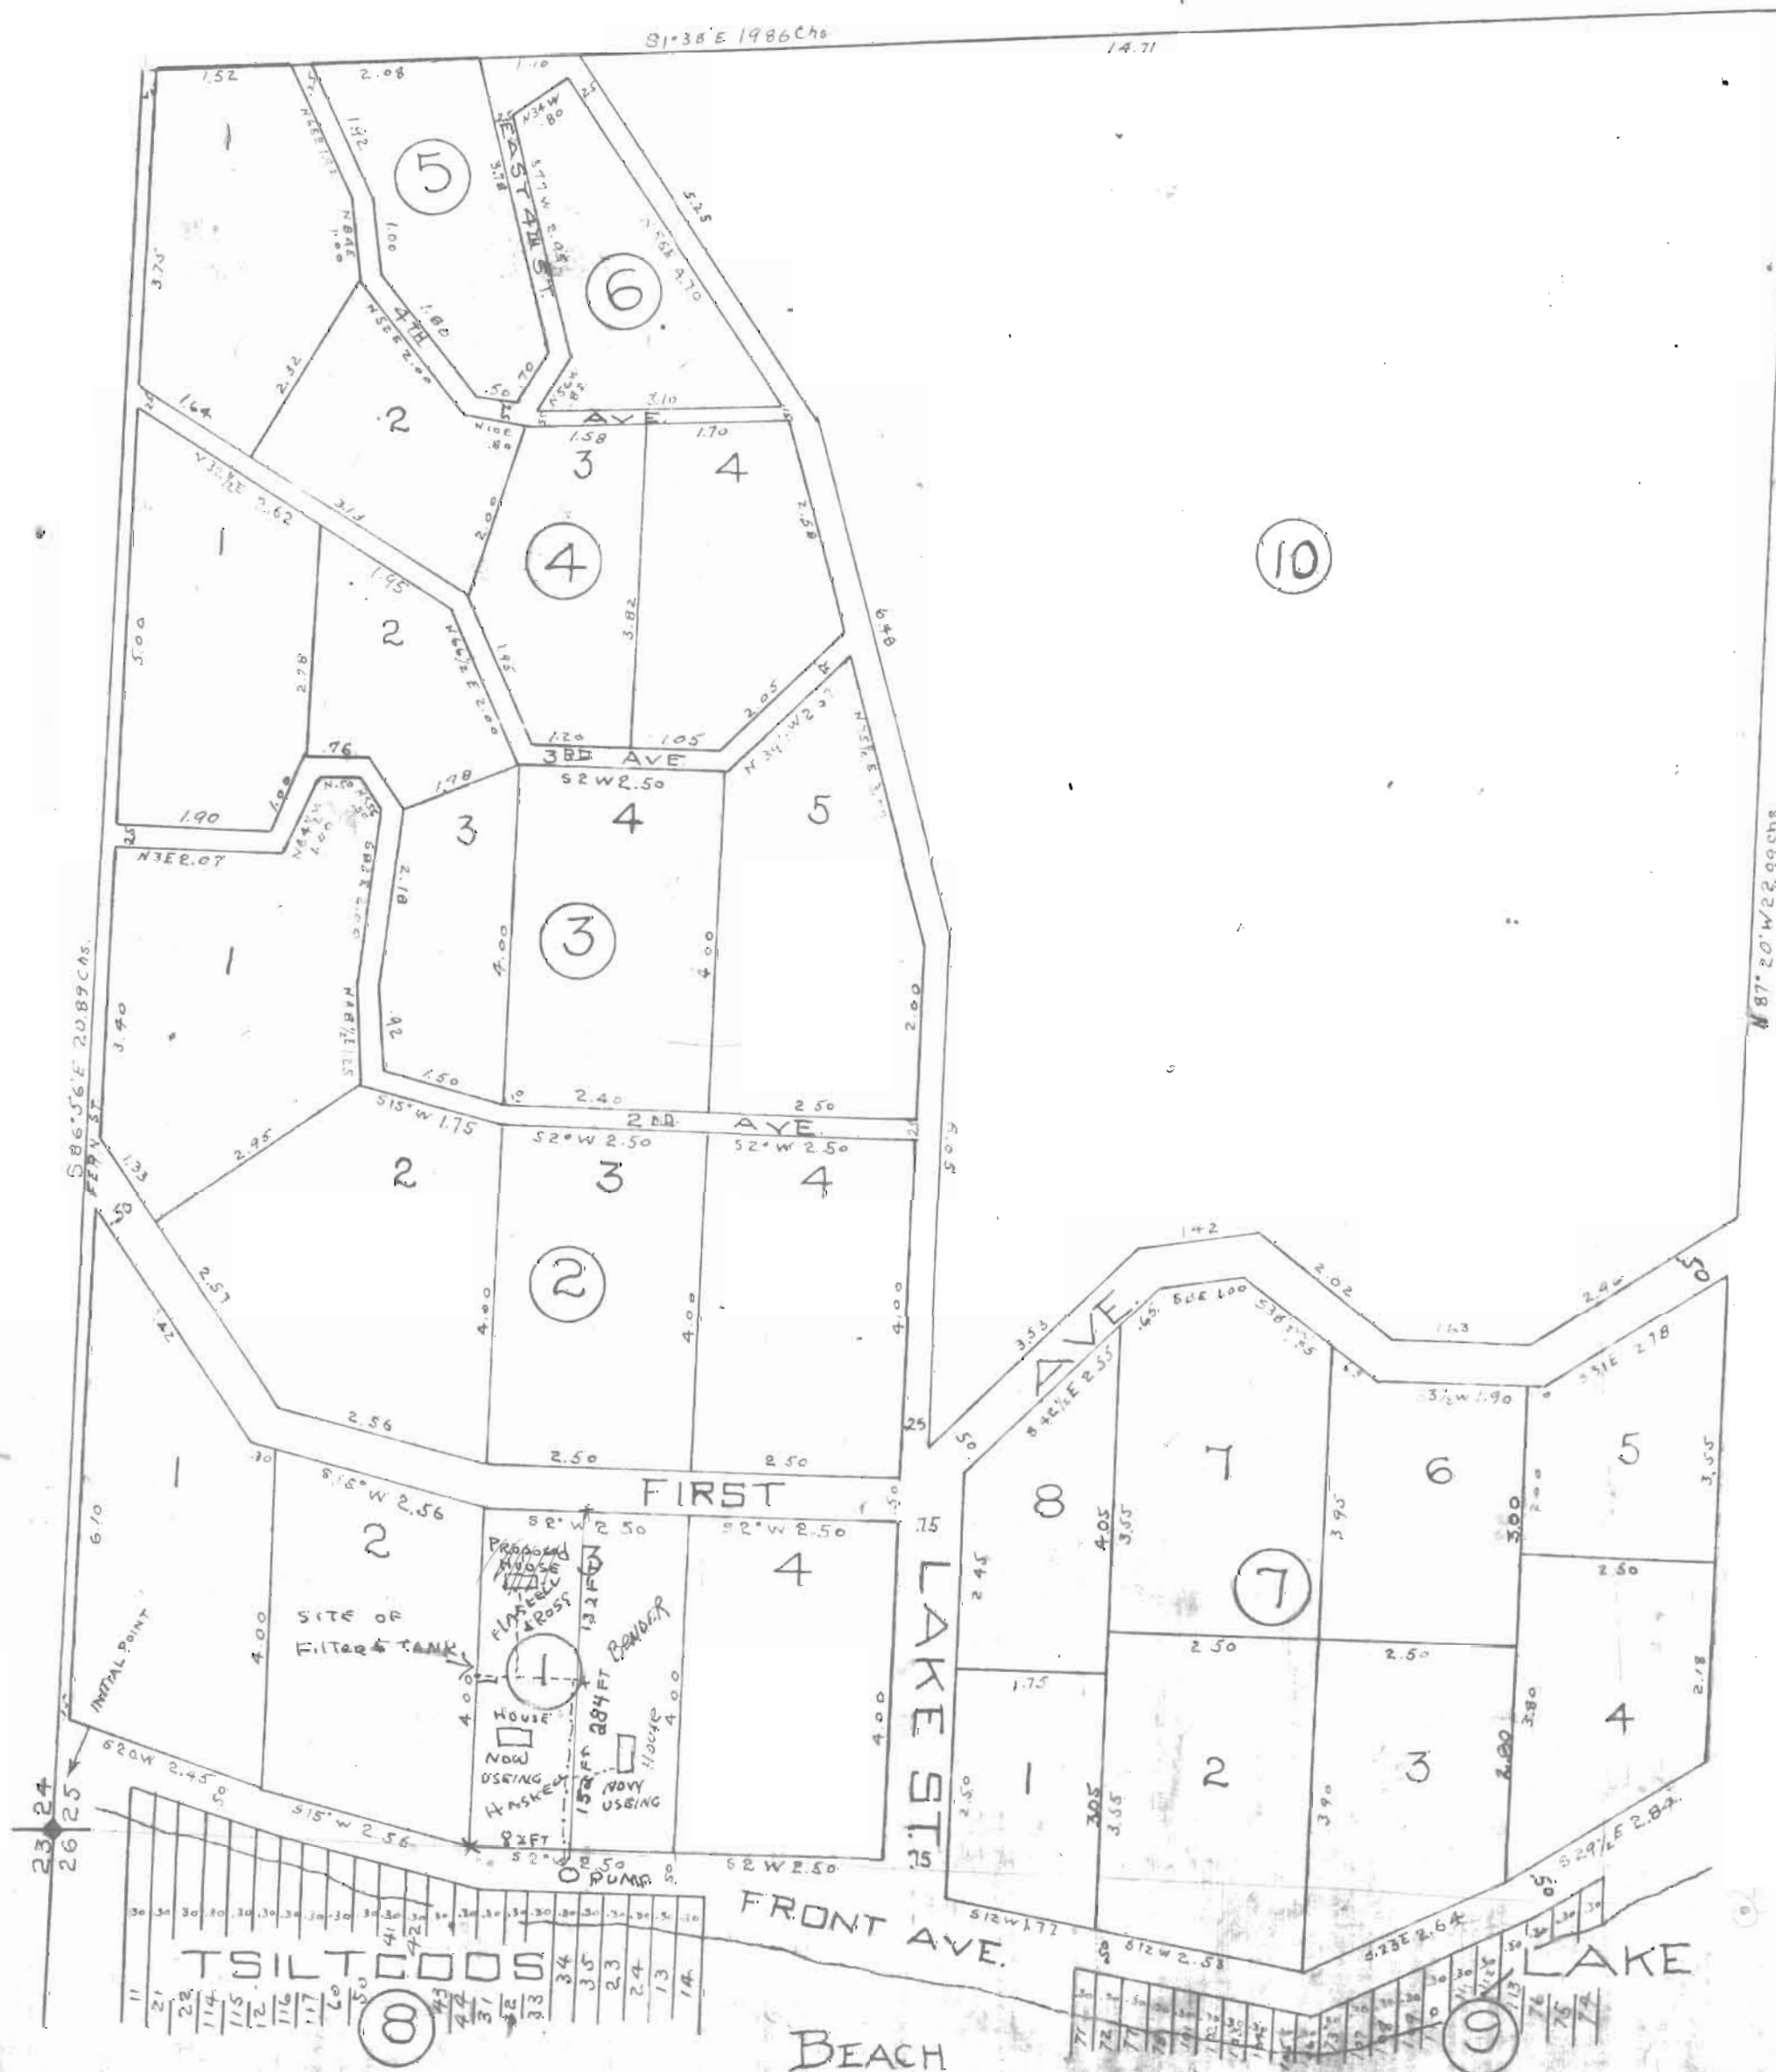

EAST  
VAR. 2 1/2 P.E.  
SCALE 1" = 200 CHS.

RECEIVED  
JAN 7 1971  
STATE ENGINEER  
SALEM, OREGON

RECEIVED  
NOV 19 1970  
STATE ENGINEER  
SALEM, OREGON