


Section 15
Township 28S
Range 12 W W M
Scale 1 inch = 660 ft.

Not to

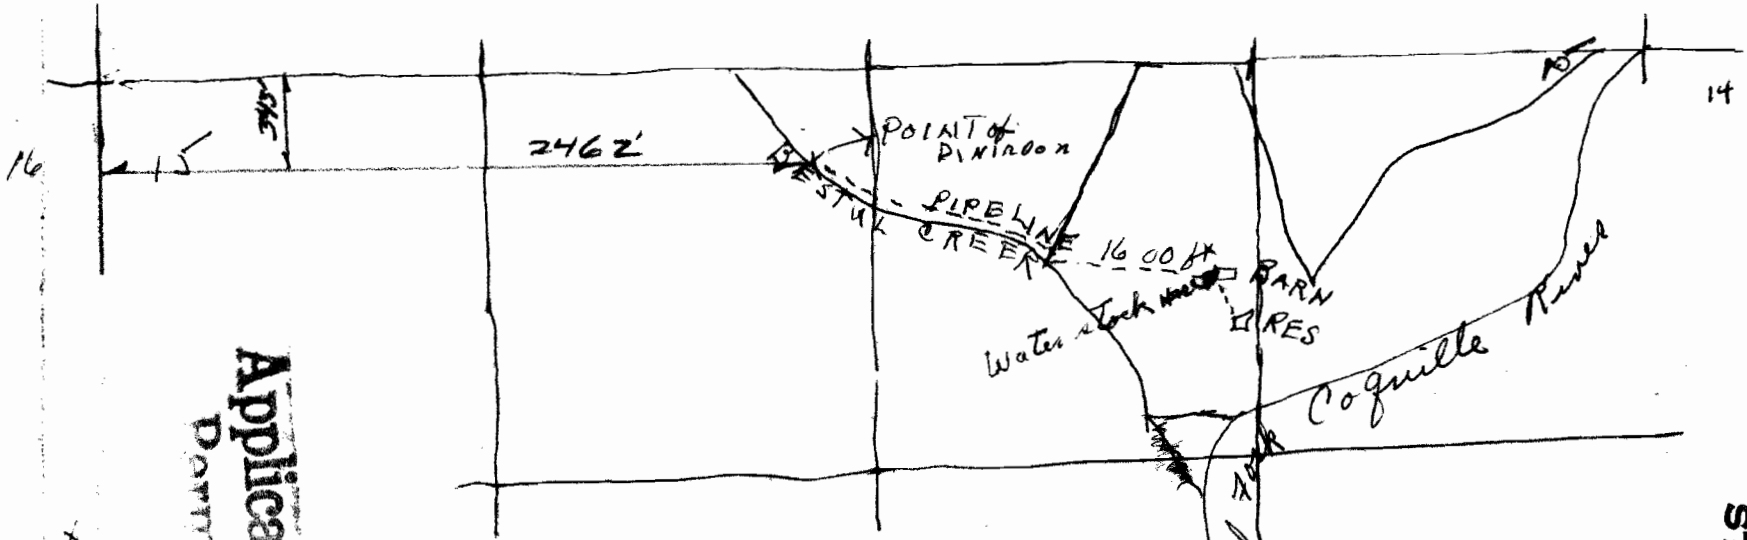

East.

RECEIVED
DEC 8 1970
STATE ENGINEER
SALEM, OREGON

RECEIVED
OCT 5 1970
STATE ENGINEER
SALEM OREGON

RECEIVED
SEP 24 1970
STATE ENGINEER
SALEM, OREGON

Application No. 475628
Permit No. 35615

West

South