


Scale 1" = 400'

T 32.5 R 6 W Sec. 25

RECEIVED
SEP 24 1970
STATE ENGINEER
SALEM OREGON

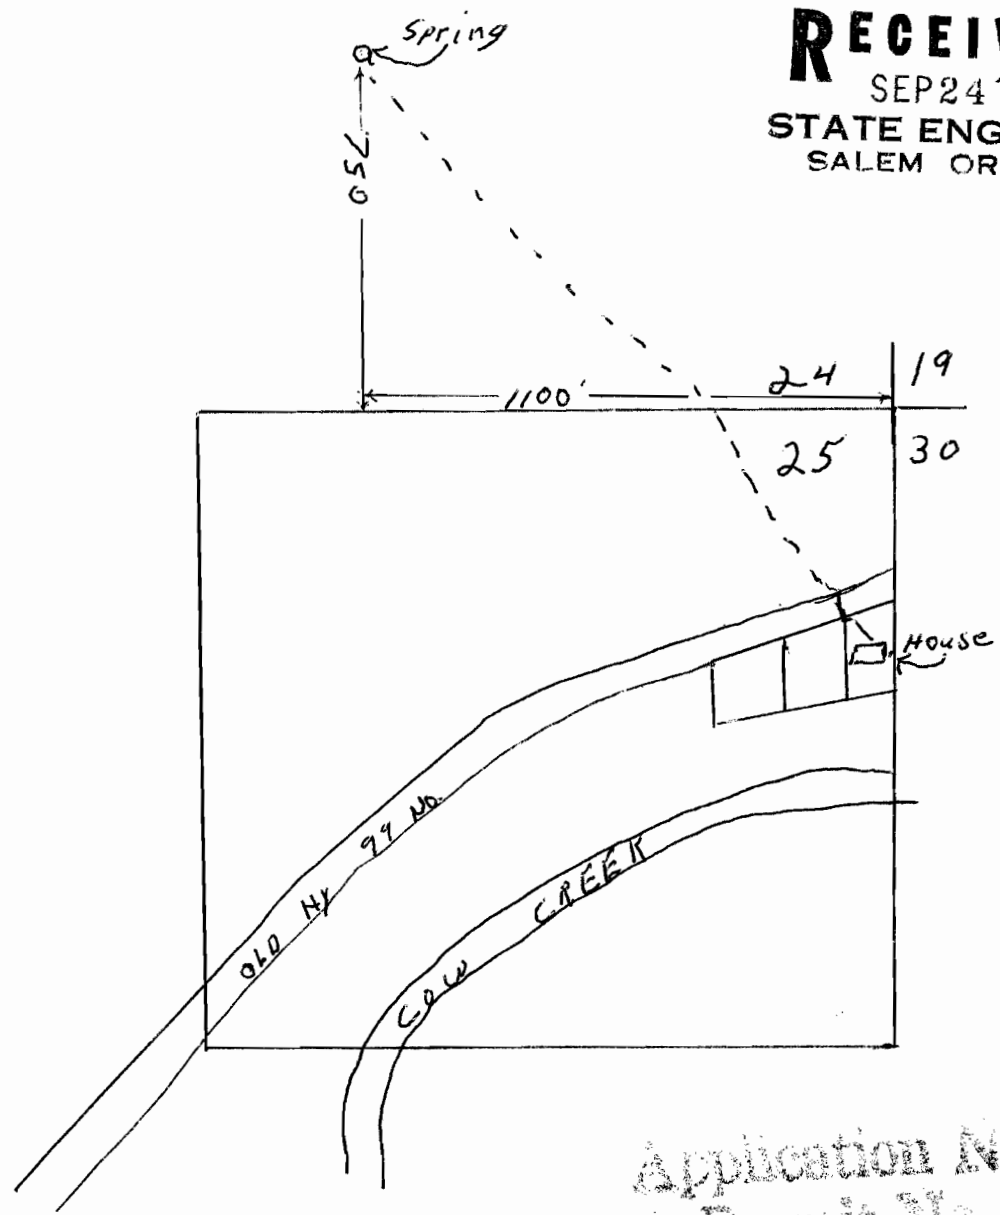

Application No. 47569
Permit No. 35616

ANDREW L. & MARIAN M. OWENS