


Application No. 47684
Permit No. 35675

Sec 17

Sec 16

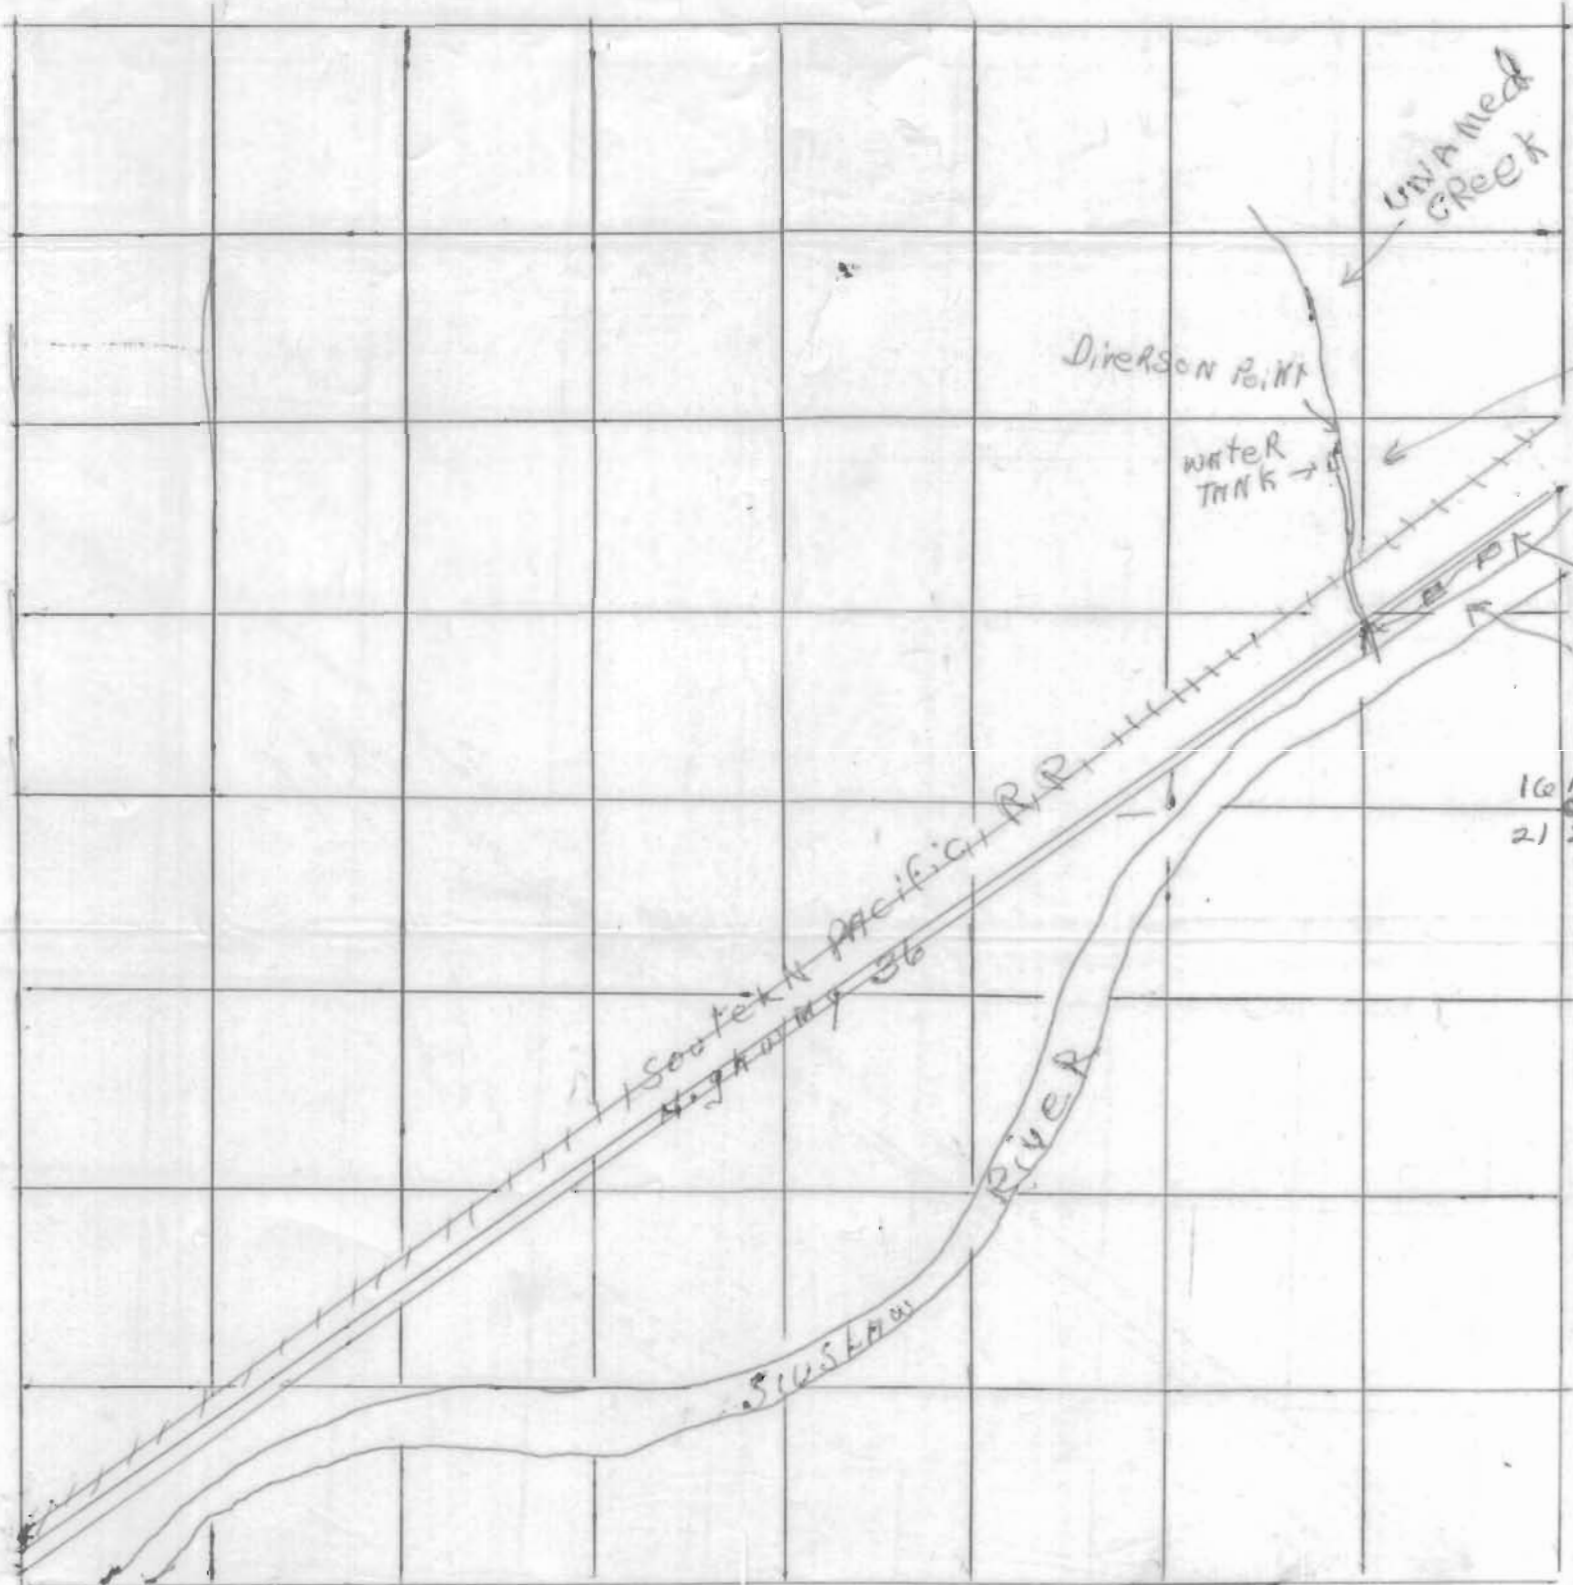

TANK 12'
FROM CREEK

Diverson Point

WATER
TANK

Mill
House

SECTION
CORNER
STONE

T185
R11W

4" = 1 mile

Sec 21

Sec 20

RECEIVED
JAN 12 1977
STATE ENGINEER
SALEM, OREGON