


Section 11 T.15. R.4E. W.M.
Multnomah County
1" = 400'

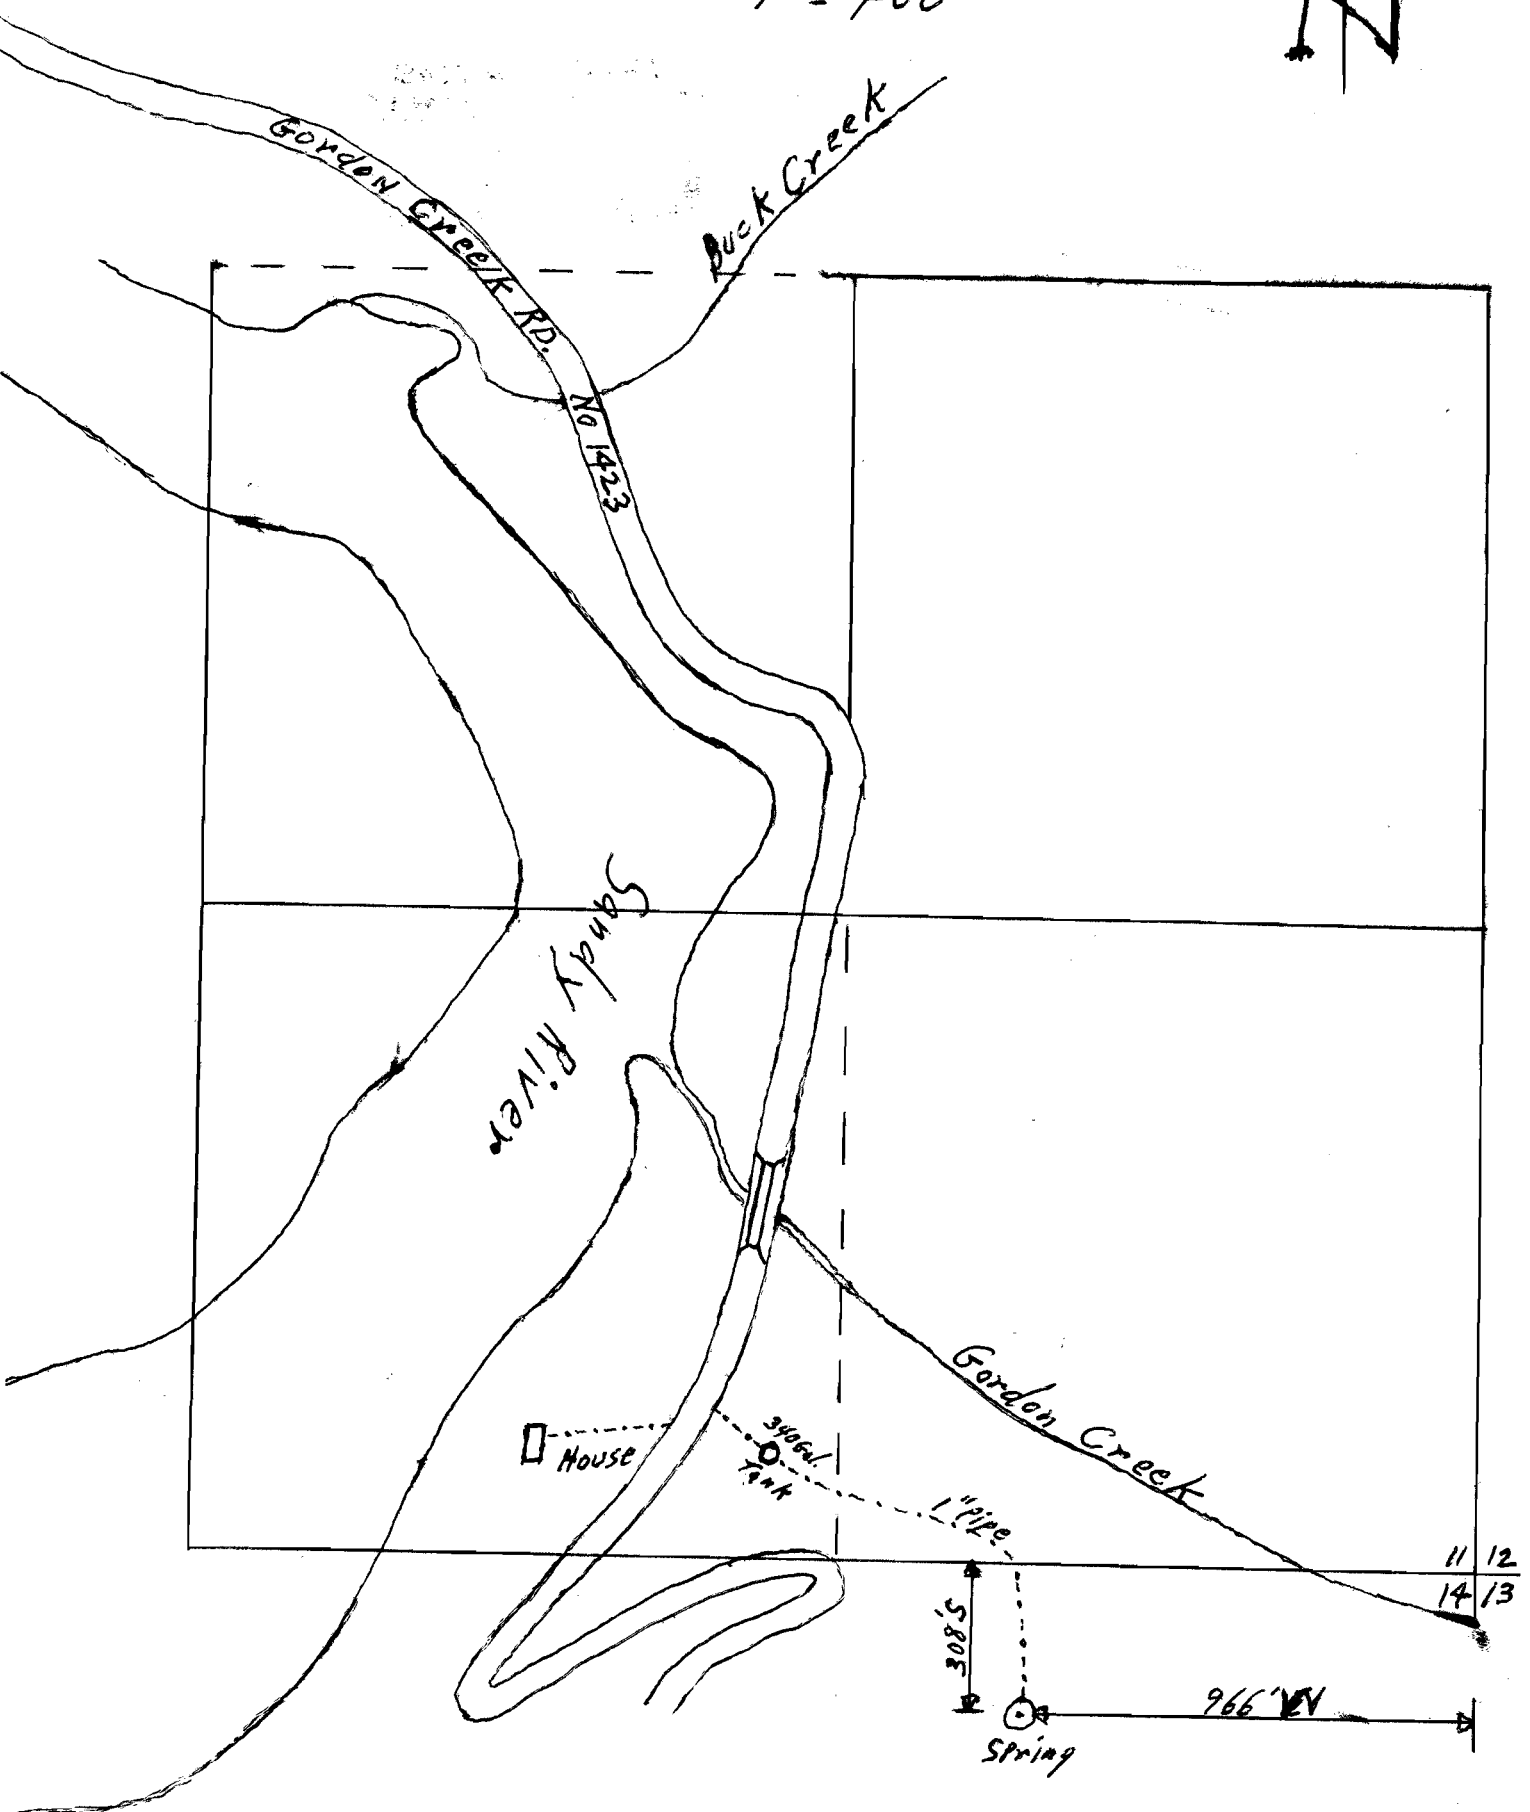

RECEIVED
MAR 15 1971
STATE ENGINEER
SALEM, OREGON

Application No. 48043
Permit No. 35687