


RECEIVED
JUN 7 1971
STATE ENGINEER
SALEM, OREGON

T25S R7W WM

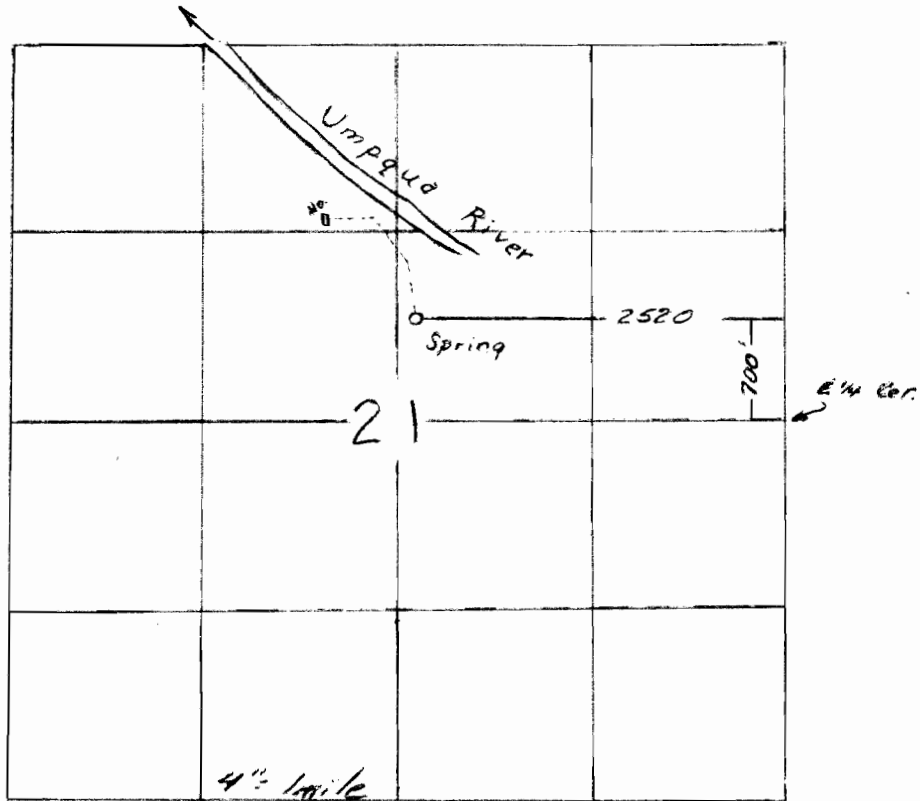

Application No. 48303
Permit No. 35689