


T.285., R.8W.W.M.

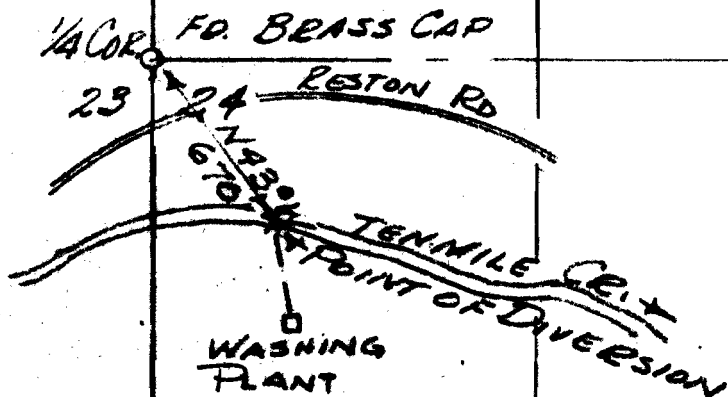

Application No. 48746
Permit No. 35719

RECEIVED
OCT 1 1971
STATE ENGINEER
SALEM, OREGON

APPLICATION MAP FOR PERMIT
TEECO CORP.
SCALE 1" = 660' SEPT. 17, 1971