


RECEIVED  
FEB 24 1971  
STATE ENGINEER  
SALEM, OREGON

RECEIVED  
MAY 17 1971  
STATE ENGINEER  
SALEM, OREGON

T. 30 S. R. 148, 15 W. W. M

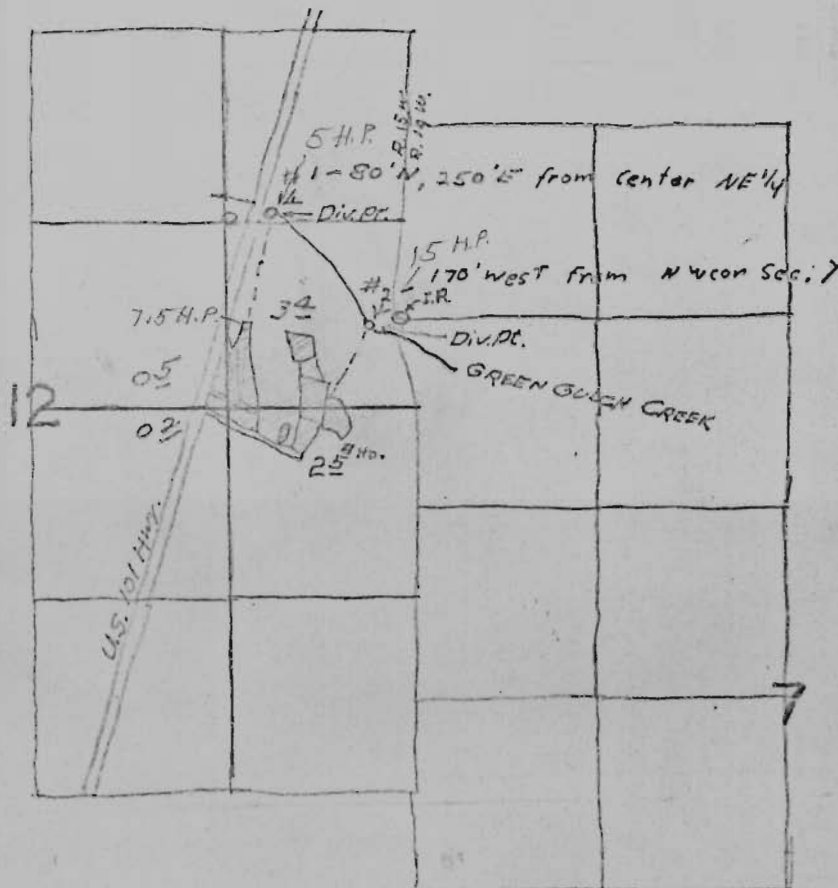

Application No. 47764  
Permit No. 35775