



35797

T.37S. R.5W. W.M.

Handwritten notes:
Miller Cr. 221 AC
276
Allowed on

T.38S. R.4&5W. W.M.

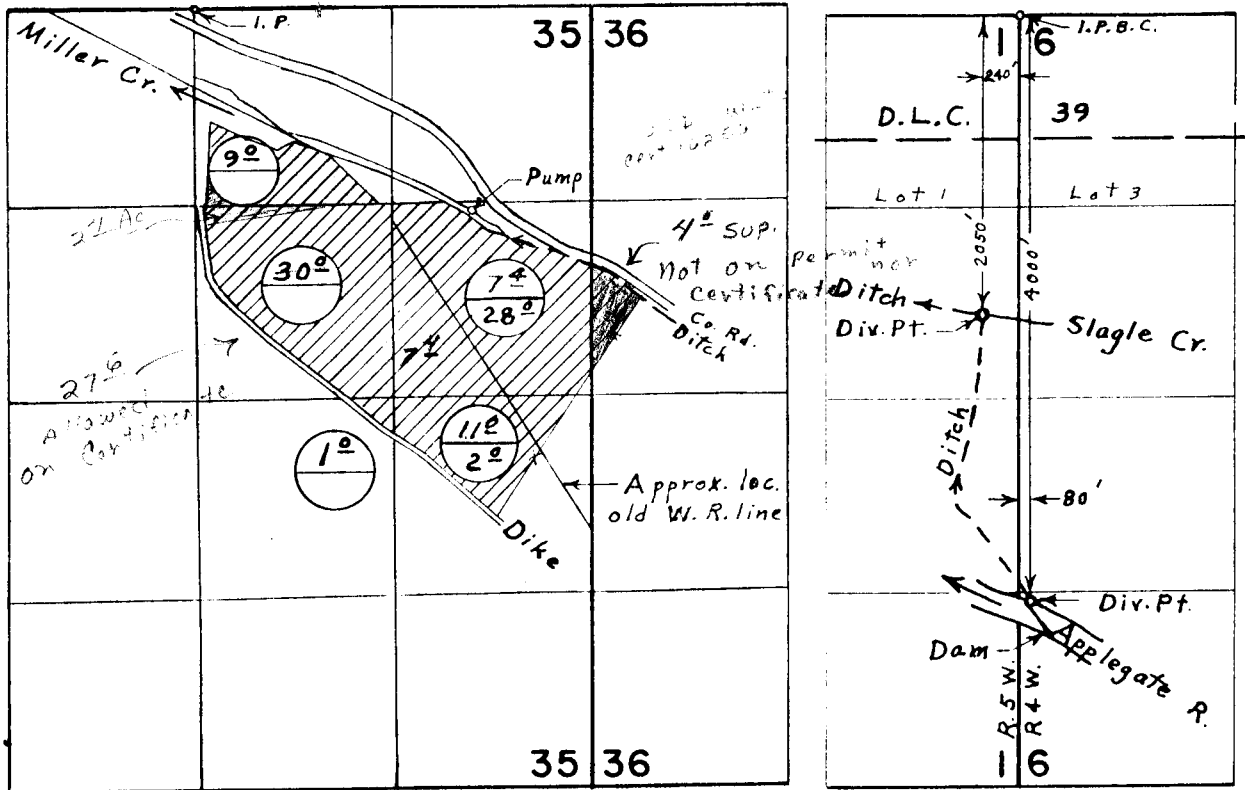

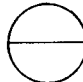New Land Irr. 
Old Rights

RECEIVED

JUN 5 1978

WM. DIST. 14
GRANTS PASS. OREG.

FINAL PROOF SURVEY UNDER

Application No. 47716 Permit No. 35797
IN NAME OF

NORTH SIDE APPLIGATE RIVER DITCH CO., INC.

Surveyed *May 17, 1975*
Sept. 16, 1974 by *Larry M. Toll*