


RECEIVED
 FEB 26 1971
 STATE ENGINEER
 SALEM, OREGON

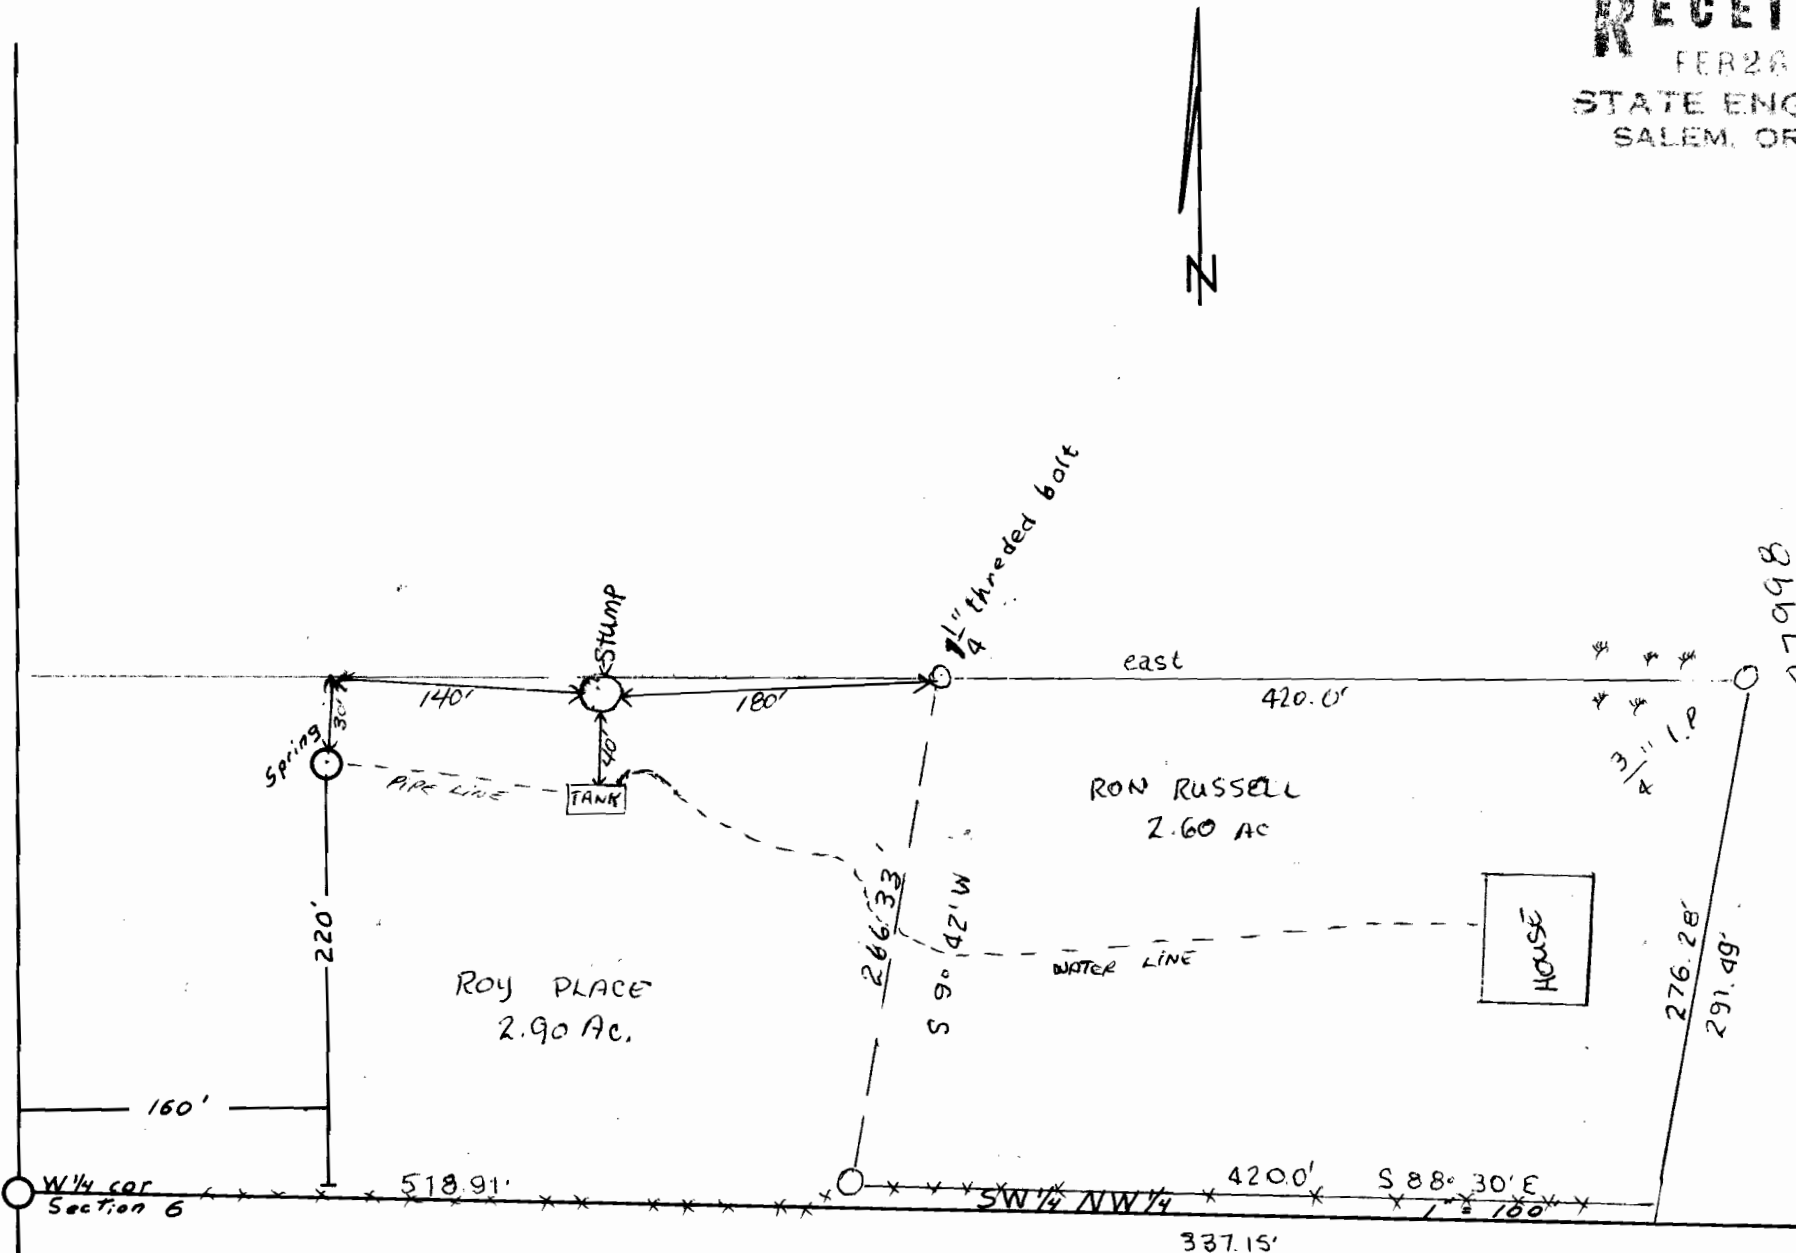

Application No. **47998**
 Permit No. **35998**

T 26 S R 12 W W M