


Sec 34 Twp 28 S.  
Range 4. W.

34

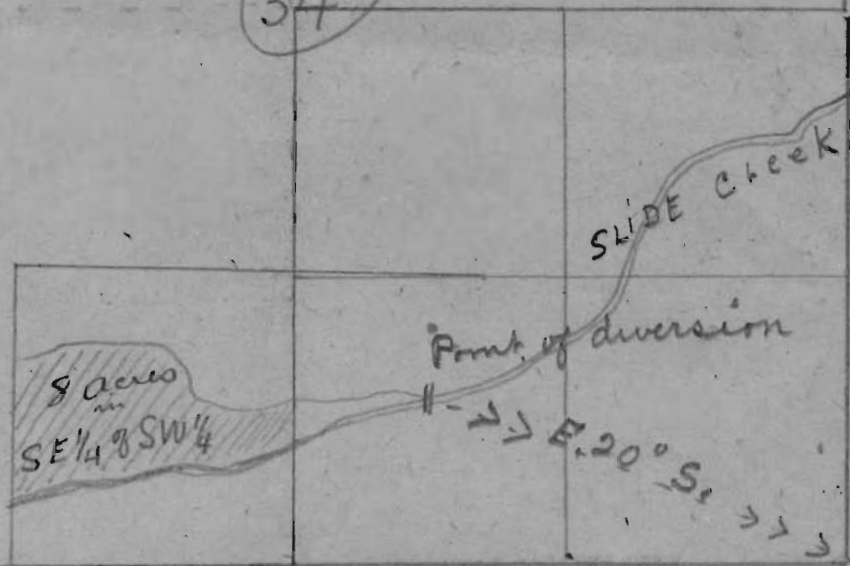

See Cr.  
Between 34 + 36  
and 2 + 3

OFFICE OF STATE ENGINEER  
RECEIVED  
NOV 21 1917  
SALEM, OREGON.

Application No. 5854  
Permit No. 3600