


T37S., R.8W., W.M.

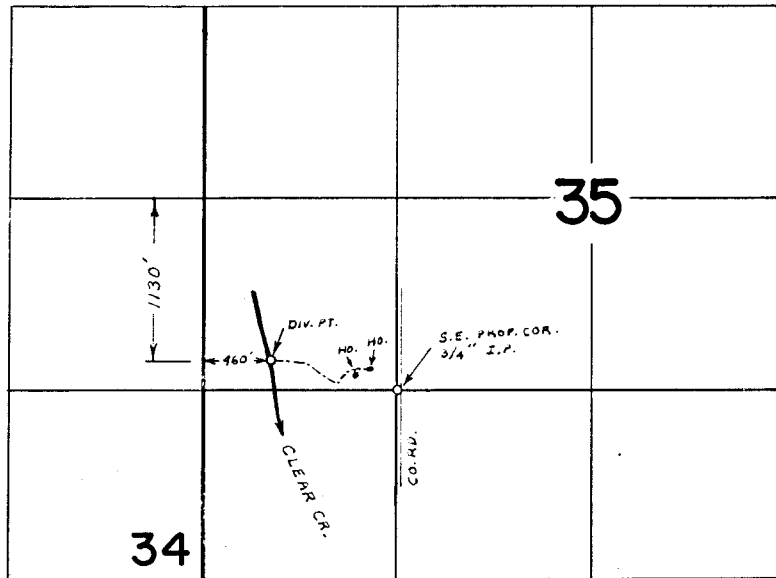

RECEIVED

MAY 18 1982

WM. DIST. 14
GRANTS PASS, ORE.

FINAL PROOF SURVEY
UNDER

Application No. 48892 Permit No. 36049
IN NAME OF

DOUGLAS MICHAEL FREIER

Surveyed OCT. 27 1978 by B. SUND

P.T.S. - 1978 - 14 - D