



Application No. 18173
Permit No. 36189

North

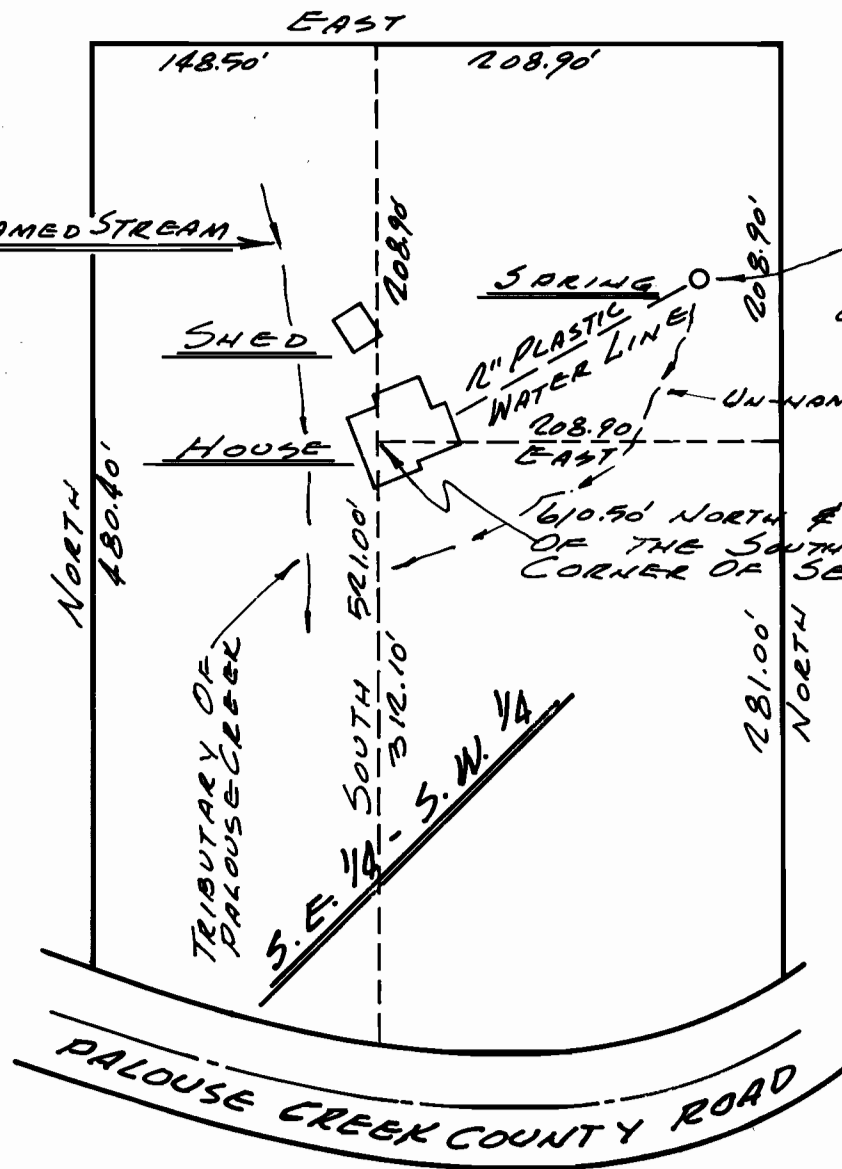

SET 3/4" IRON PIPE
LOCATION OF SPRING - 691.09' NORTH
1634.43' EAST OF THE SOUTHWEST
CORNER OF SECTION 9, TOWNSHIP
24 SOUTH, RANGE 12 WEST, W.M.,
COOS COUNTY, OREGON

ELEVATIONS
SPRING 100.0
HOUSE 59.0

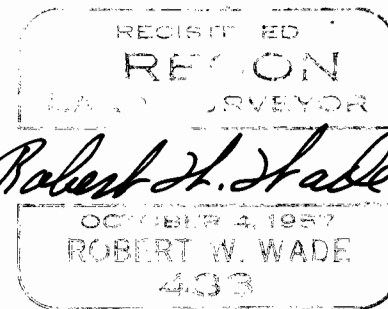

WATER RIGHTS SURVEY
IN THE S.E. 1/4 OF THE
S.W. 1/4 OF SECTION 9,
TOWNSHIP 24 SOUTH,
RANGE 12 WEST, W.M.,
COOS COUNTY, OREGON
SCALE: 1" = 100' 4-21-71
FOR ROBERT H. HARRISON
1131 HAYNES WAY
NORTH BEND, OREGON
H. G. E. INC.
405 NORTH 5TH.
COOS BAY, OREGON