


RECEIVED
AUG 2 1971
STATE ENGINEER
SALEM, OREGON

T.40S. R.8W.W.M.

Scale 1"=400'

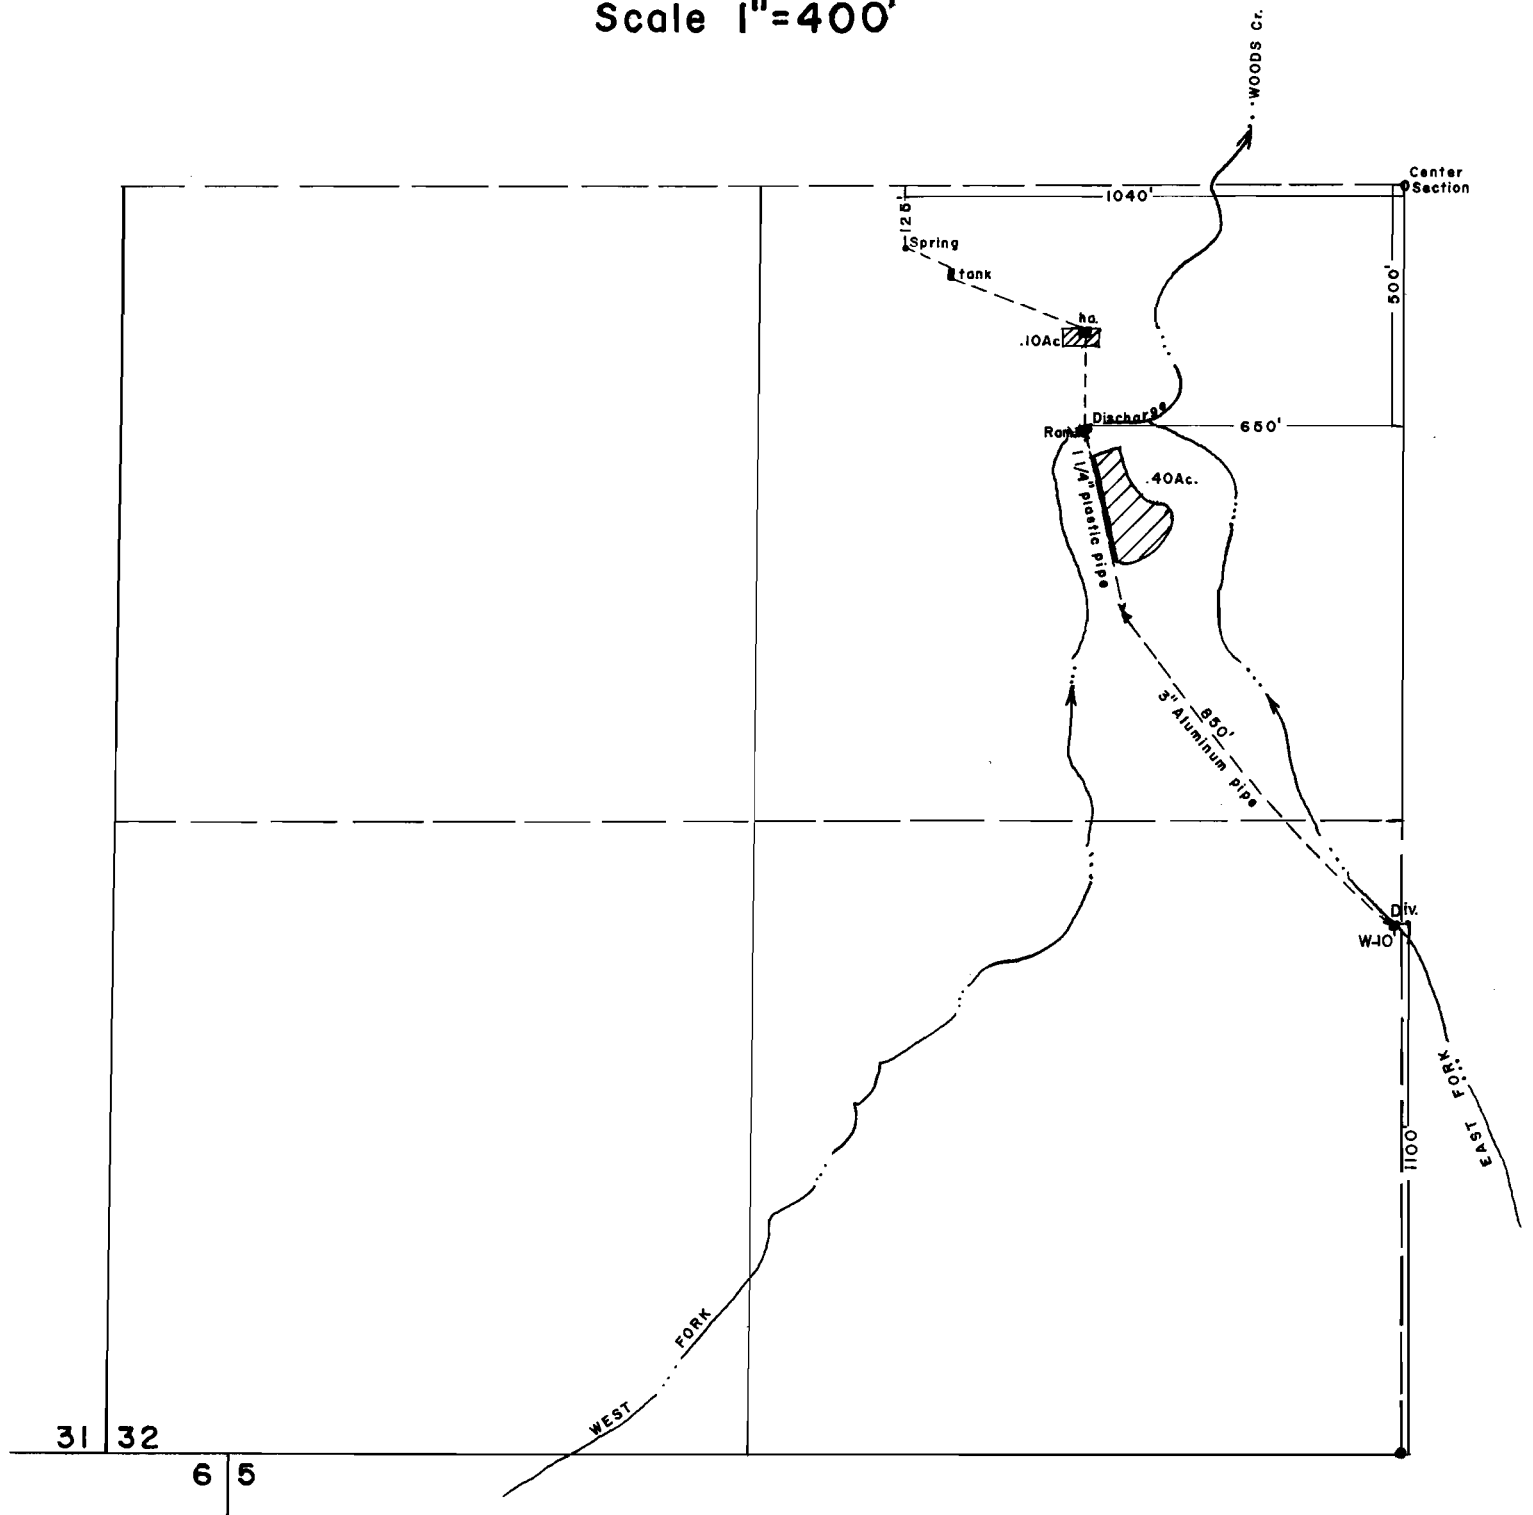

WILLIAM J. FRAINEY

Application No. 48114
Permit No. 36247