


Permit: S 36299
Volume: 5B
Strm: UNN SPR
Trib: GRAVE CR
Priority: 6/17/71

35

T.33S.R.6W.W.M.

36299

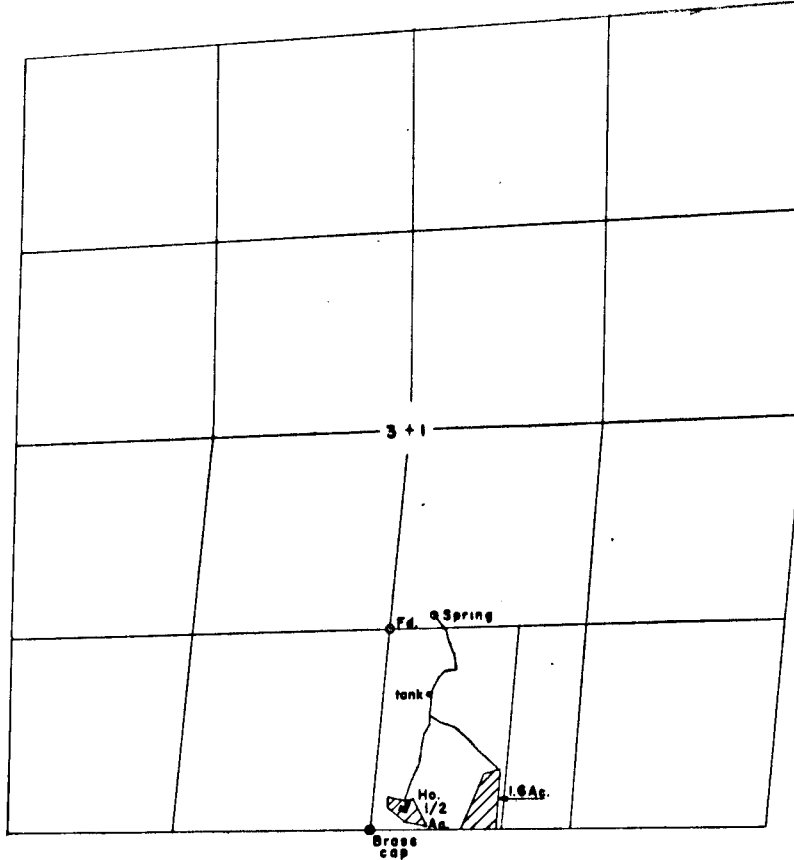

Spring is located 90' N. & 290' E. from the N.W. COR. OF the S.W. 1/4 S.E. 1/4

RECEIVED
JAN 29 1975

**FINAL PROOF SURVEY
UNDER**

W.M. DIST. 14
GRANTS: PACE, CORE.

Application No. 48342.. Permit No. 36299..
IN NAME OF

.....HERBERT B. DUNHAM.....

Surveyed April 10, 1974, by R.B. STEIMER.