

RECEIVED
MAY 10 1971
STATE ENGINEER
SALEM, OREGON

805' E.

797' E.

1/16 COR.



1,390' N.

1,300' N.

1" = 100'

Cent. Sec. 26, T.19S, R.12 W.

TSILTCOOS
LAKE

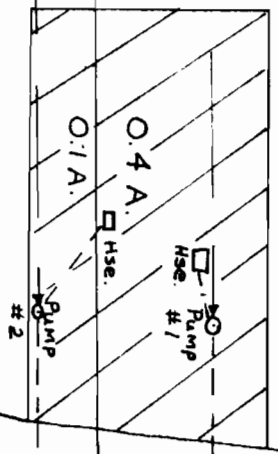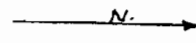

TSILTCOOS

LAKE
TSILTCOOS

Application No. 48344
Permit No. 36300