
67 394d '11. 701

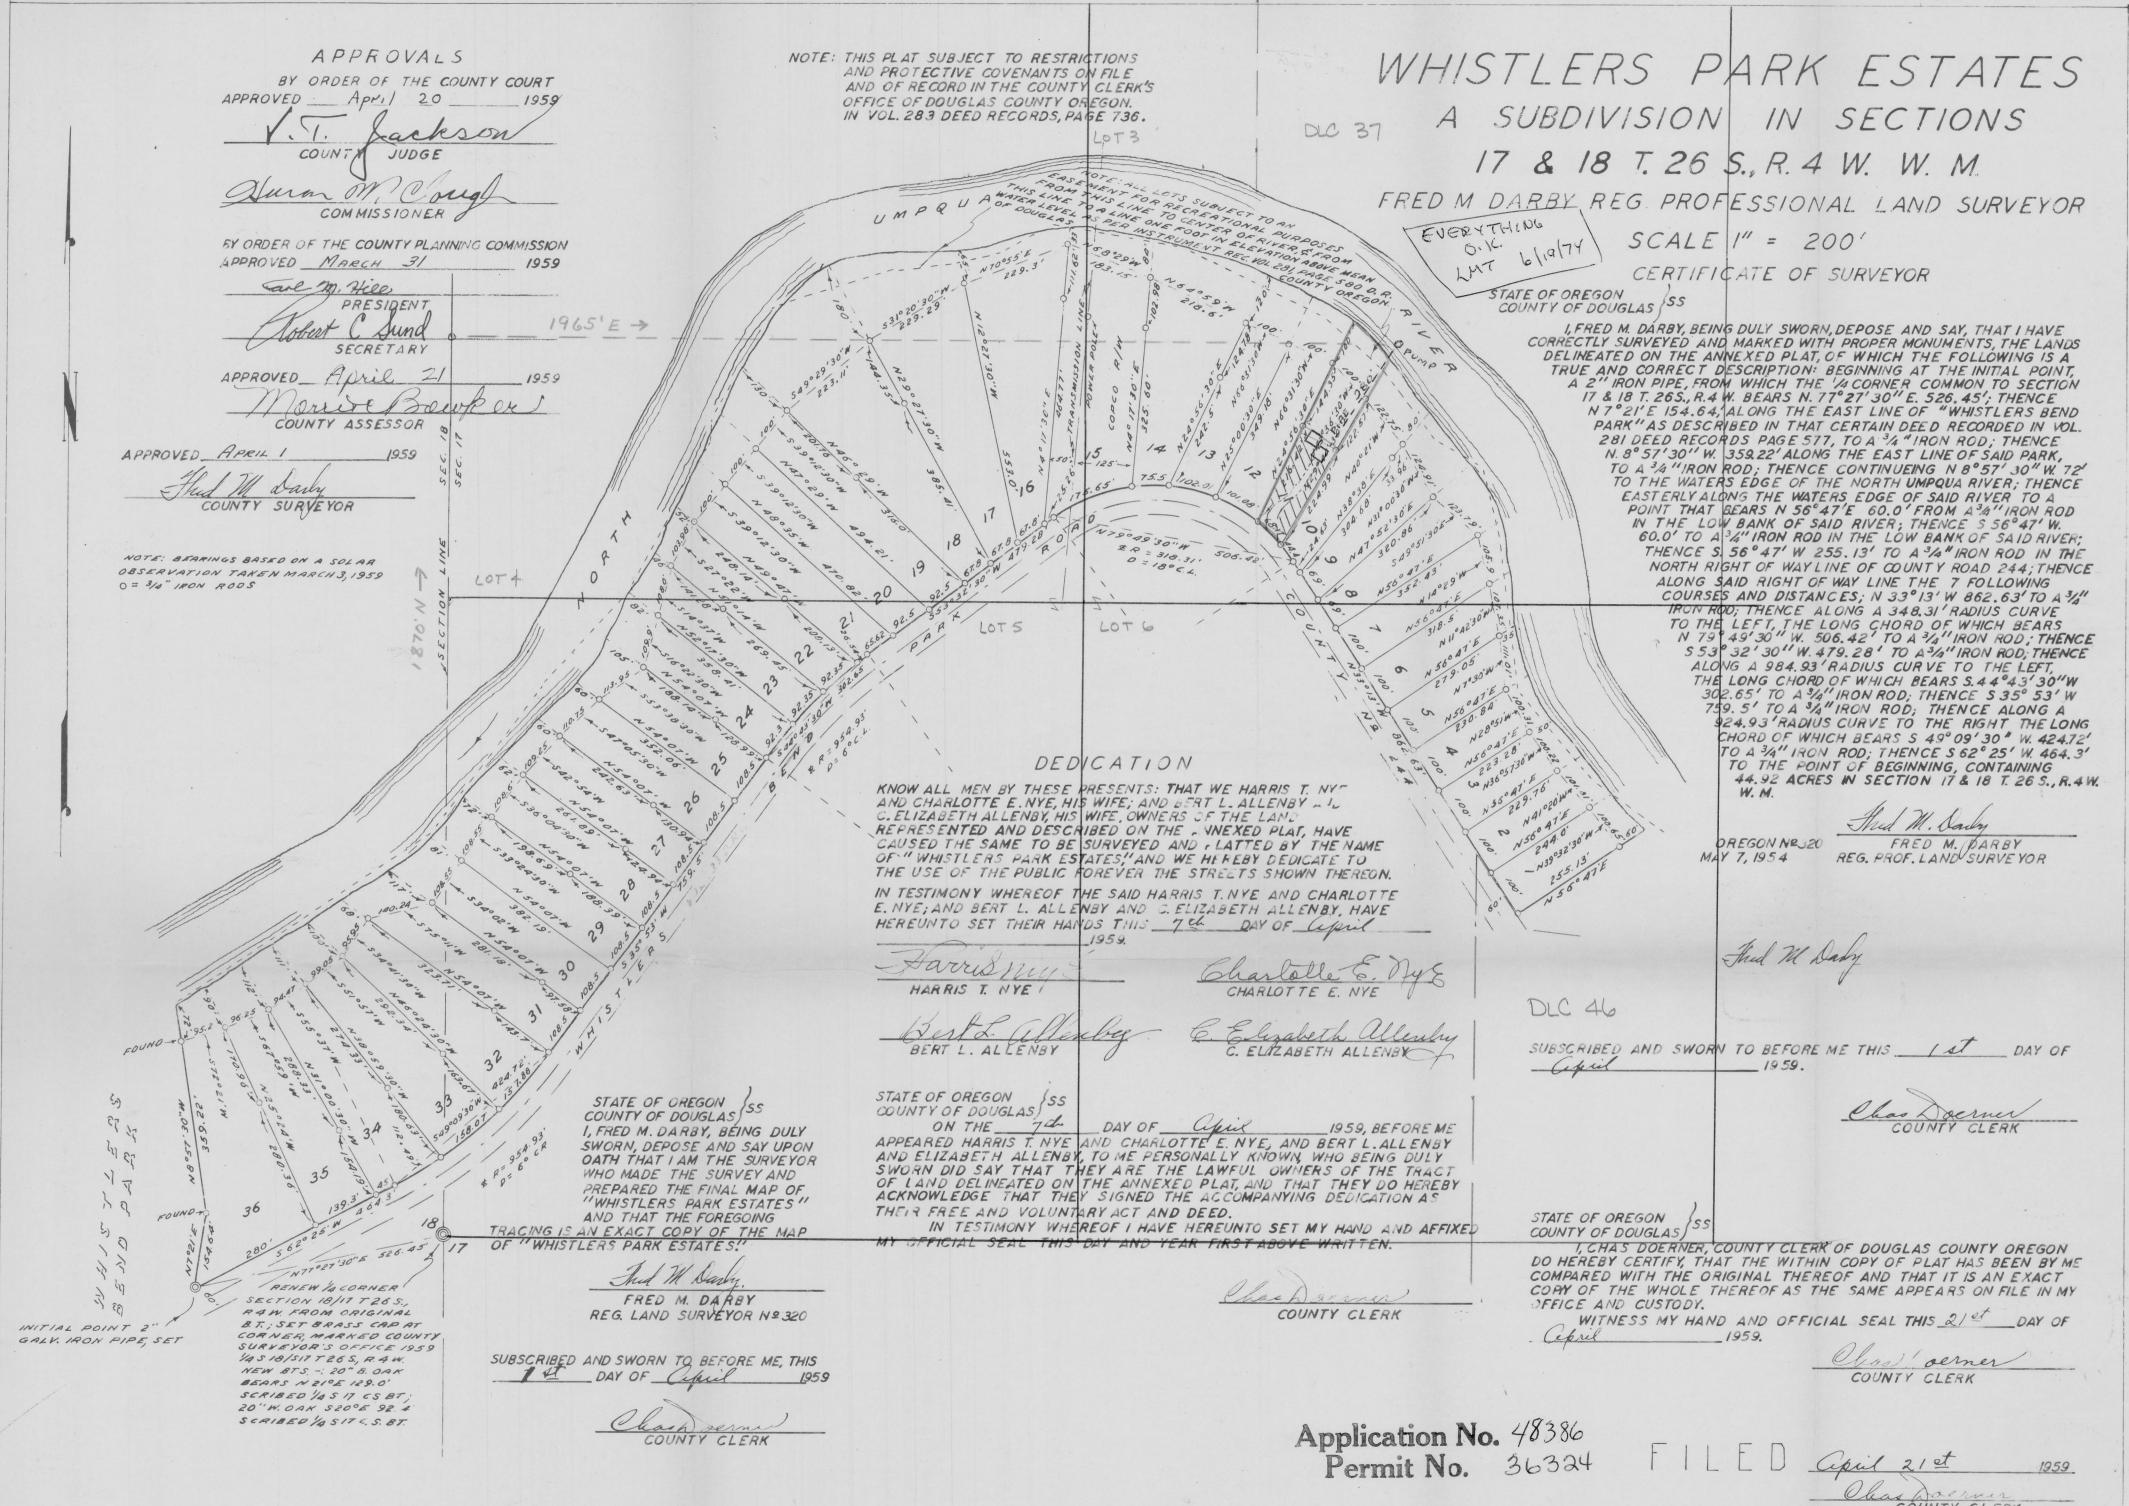

VOL. 11, PAGE 49