


T. 35 S., R. 7 W., W.M.

RECEIVED

APR 17 1981

WM. DIST. 14
GRANTS PASS, ORE

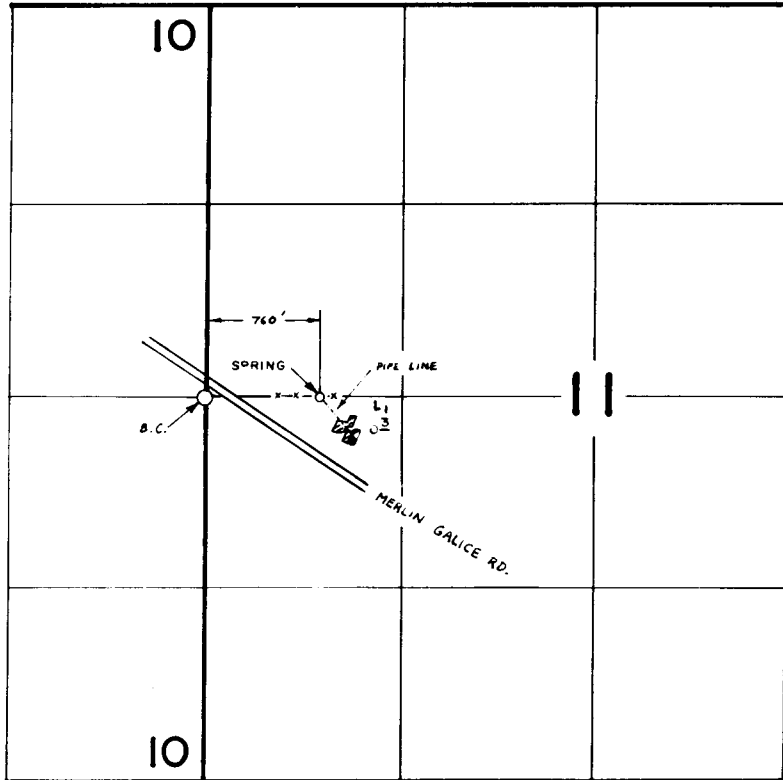

FINAL PROOF SURVEY
UNDER

Application No 48387 Permit No. 36325
IN NAME OF

GORDON T. FURMIDGE

Surveyed SEPT. 30 1977, by B. SUND