


Twp. 39 S R. 5 W

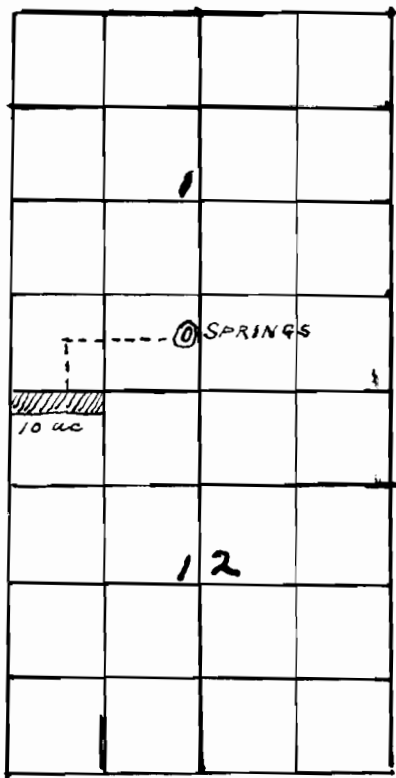

5900

3635