


T.36S. R.7 W. W.M.

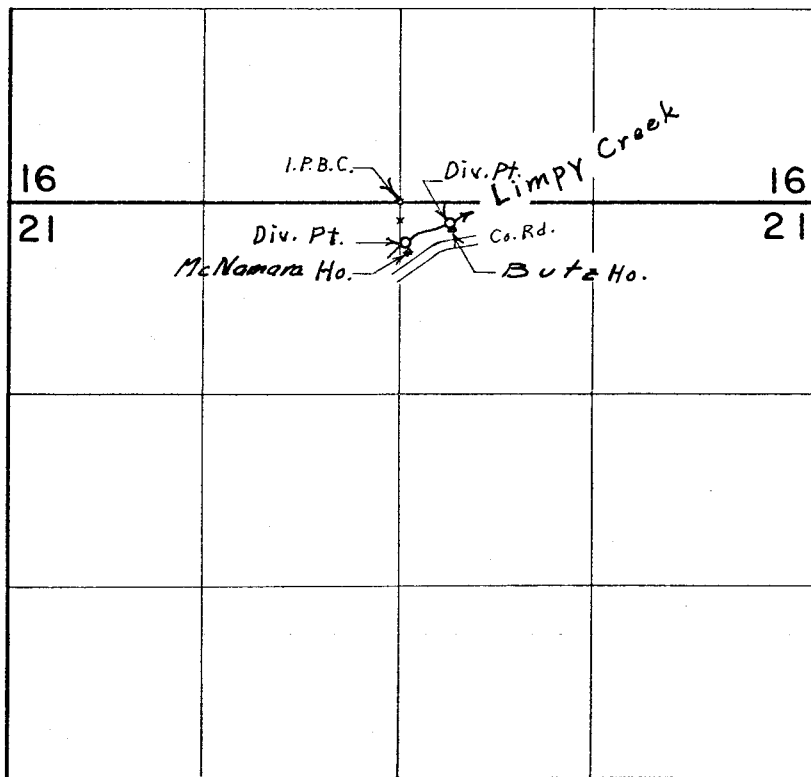

Div. Pts. located, 150' S. & 340' E., 270' S. & 30' E., both from N. $\frac{1}{4}$ Corner Section 21

FINAL PROOF SURVEY
UNDER

RECEIVED

AUG 3 1978

WM. DIST. 14
GRANTS PASS, ORE

Application No. 48445 Permit No. 36363

IN NAME OF

Jerry A. & Frances M. Butz
John & Cheryl S. McNamara
Surveyed April 10, 1975, by L. E. Gould