


Surveyed by
Robert W. Wade

REGISTERED
PROFESSIONAL
LAND SURVEYOR

OREGON
OCTOBER 4, 1957
ROBERT W. WADE
433

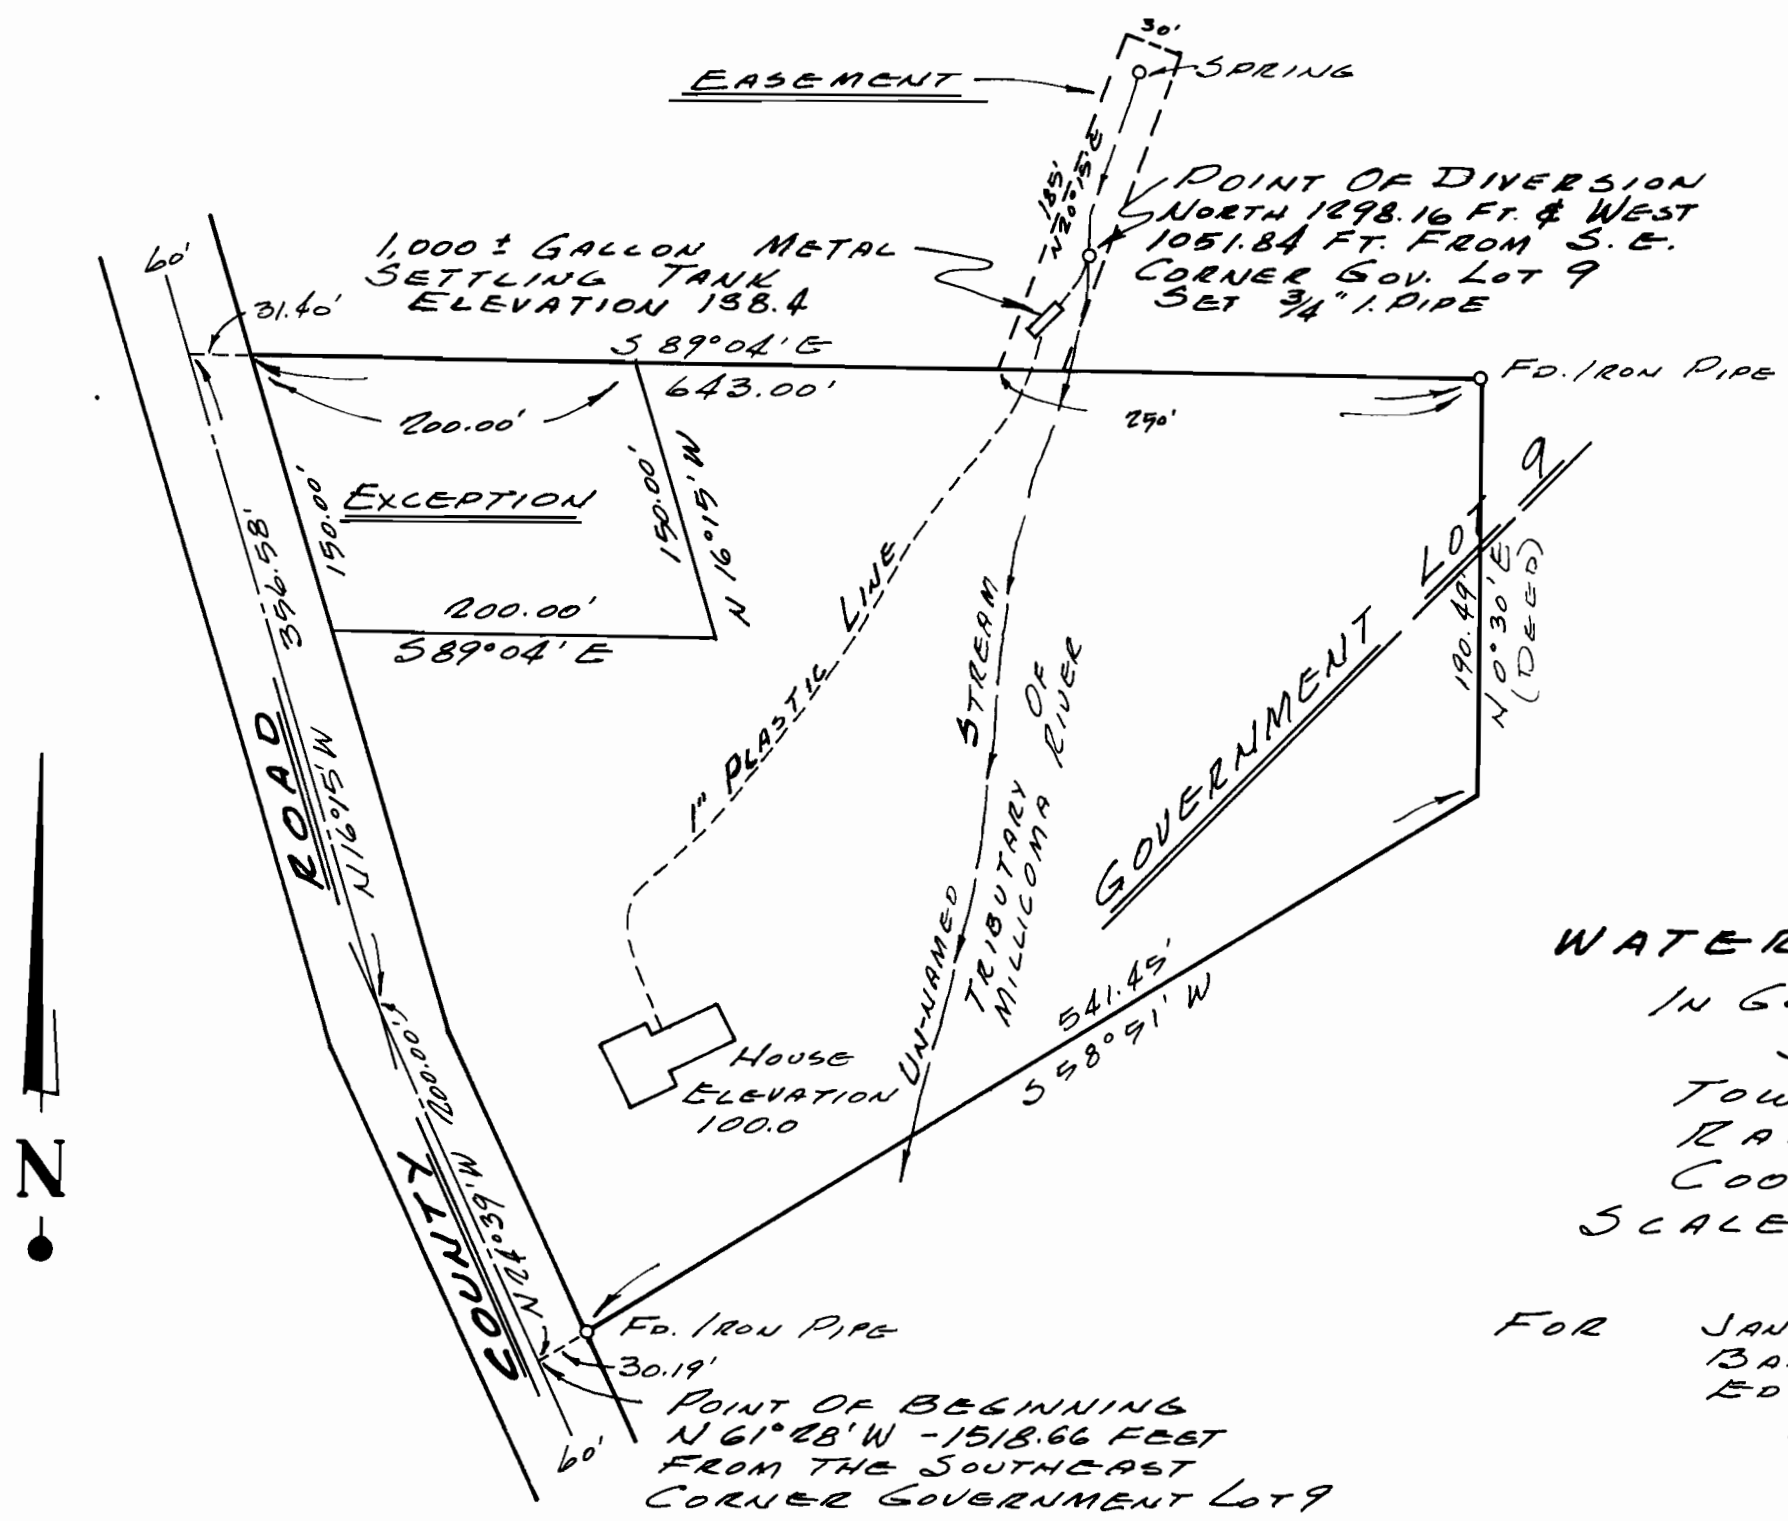

WATER RIGHTS SURVEY
IN GOVERNMENT Lot 9,
SECTION 26,
TOWNSHIP 25 SOUTH,
RANGE 12 WEST, W.M.,
COOS COUNTY, OREGON
SCALE: 1"=100' 5-18-72

FOR JANET W. FLORES
BARBARA C. MATNEY
EDWARD O. WOLCOTT
AS TRUSTEES

Application No. 49273
Permit No. 36411

REVISED 6-21-72 R.W.A.



ENGINEERS • PLANNERS

5TH AND HIGHLAND
COOS BAY, OREGON
262-1166