

OR-8
App. 2/23/55

UNITED STATES DEPARTMENT OF AGRICULTURE
Soil Conservation Service
Oregon

RECEIVED
JUN 30 1972
STATE ENGINEER
SALEM, OREGON

LOCATION OF A.C.P. PRACTICES

Program Year _____

Operator E.L. DAVENPORT ~~W~~ A.L. Lambeth A.C.P. Farm No. _____

County _____ ^{OR}

Section 13 Township 22S Range 10W Aerial Photo No. _____


1" = 660'



RECEIVED
AUG 1 1972
STATE ENGINEER
SALEM, OREGON

Application No. 49400
Permit No. 36412

13

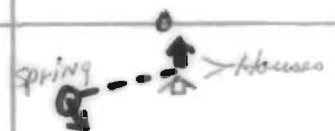

Spring is 1100' S 77°W FROM
E 1/4 COR. Thence N 77°E 300' TO
Point of use