


T13S., R31E., WM

RECEIVED
MAY 1 1971
STATE ENGINEER
SALEM, OREGON

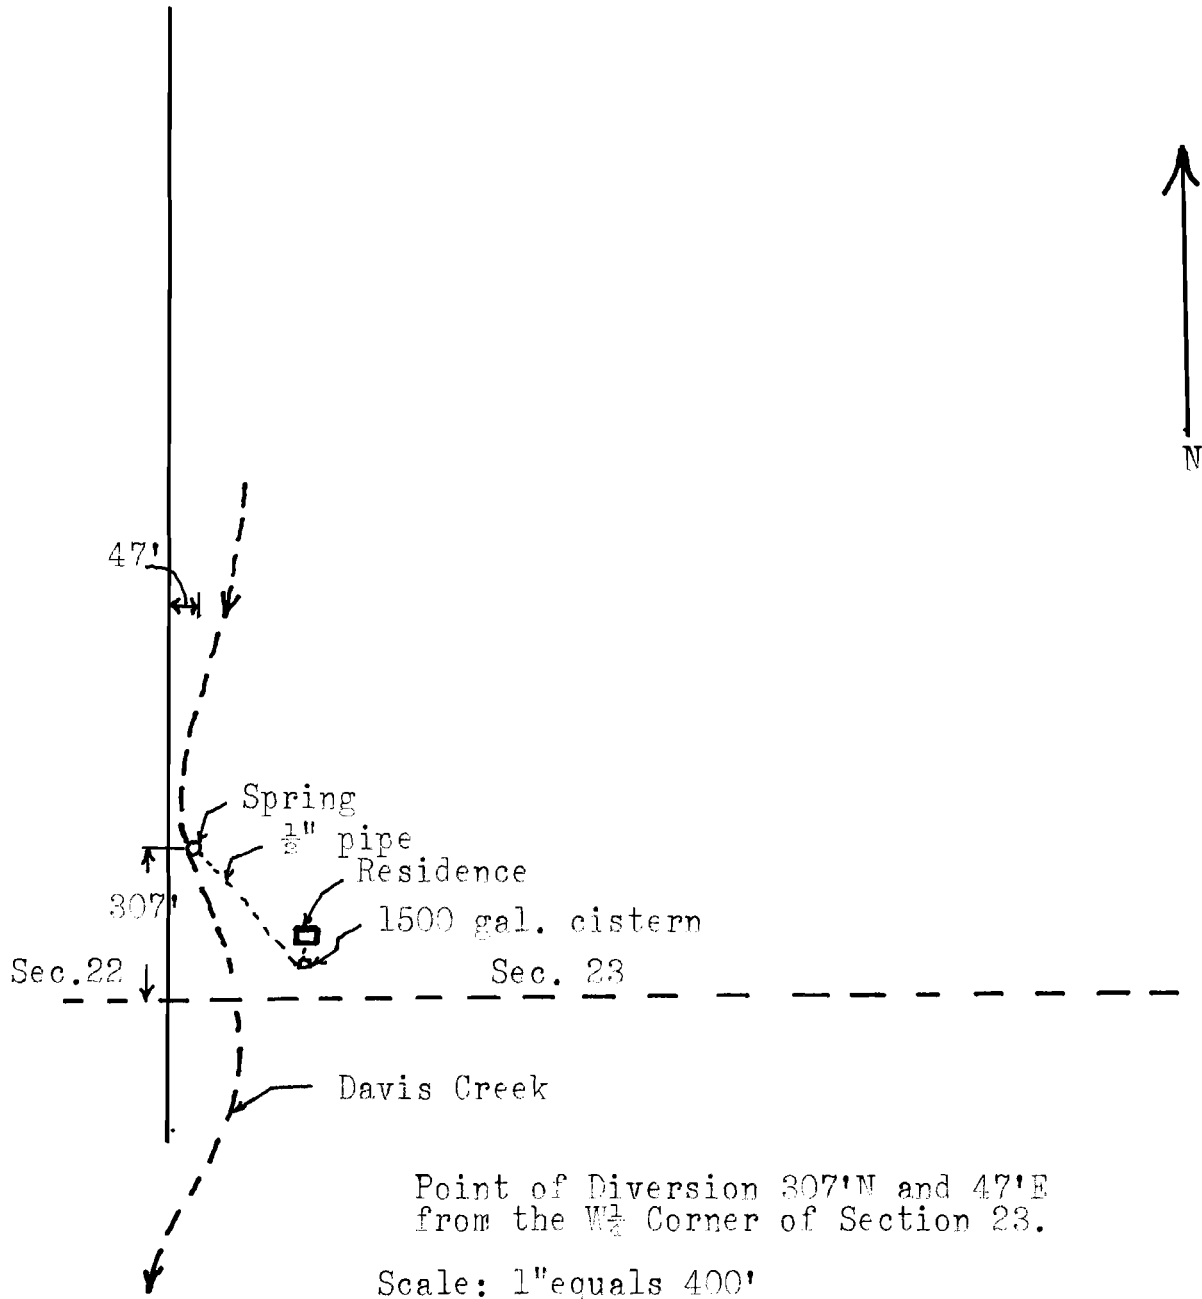

Application No. 48583
Permit No. 36455