


T. 32 S. R. 6 W. W.M.

RECEIVED
NOV 9 1971
STATE ENGINEER
SALEM OREGON

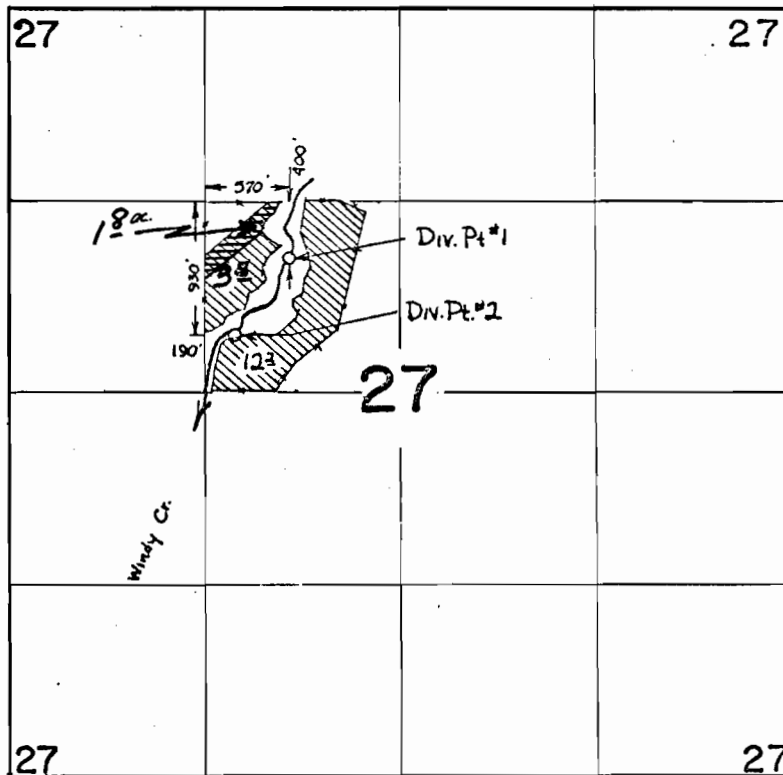

Application No. 48654
Permit No. 36490

FINAL PROOF SURVEY

UNDER

Application No. 42427... Permit No. 31746.....

IN NAME OF

J. D. SANDERS

Surveyed 4 JUNE 1970..., by D. R. BUELL