


RECEIVED
SEP 3 1971
STATE ENGINEER
SALEM OREGON

T4N R4W WM
Section 3
Scale 1" = 400'

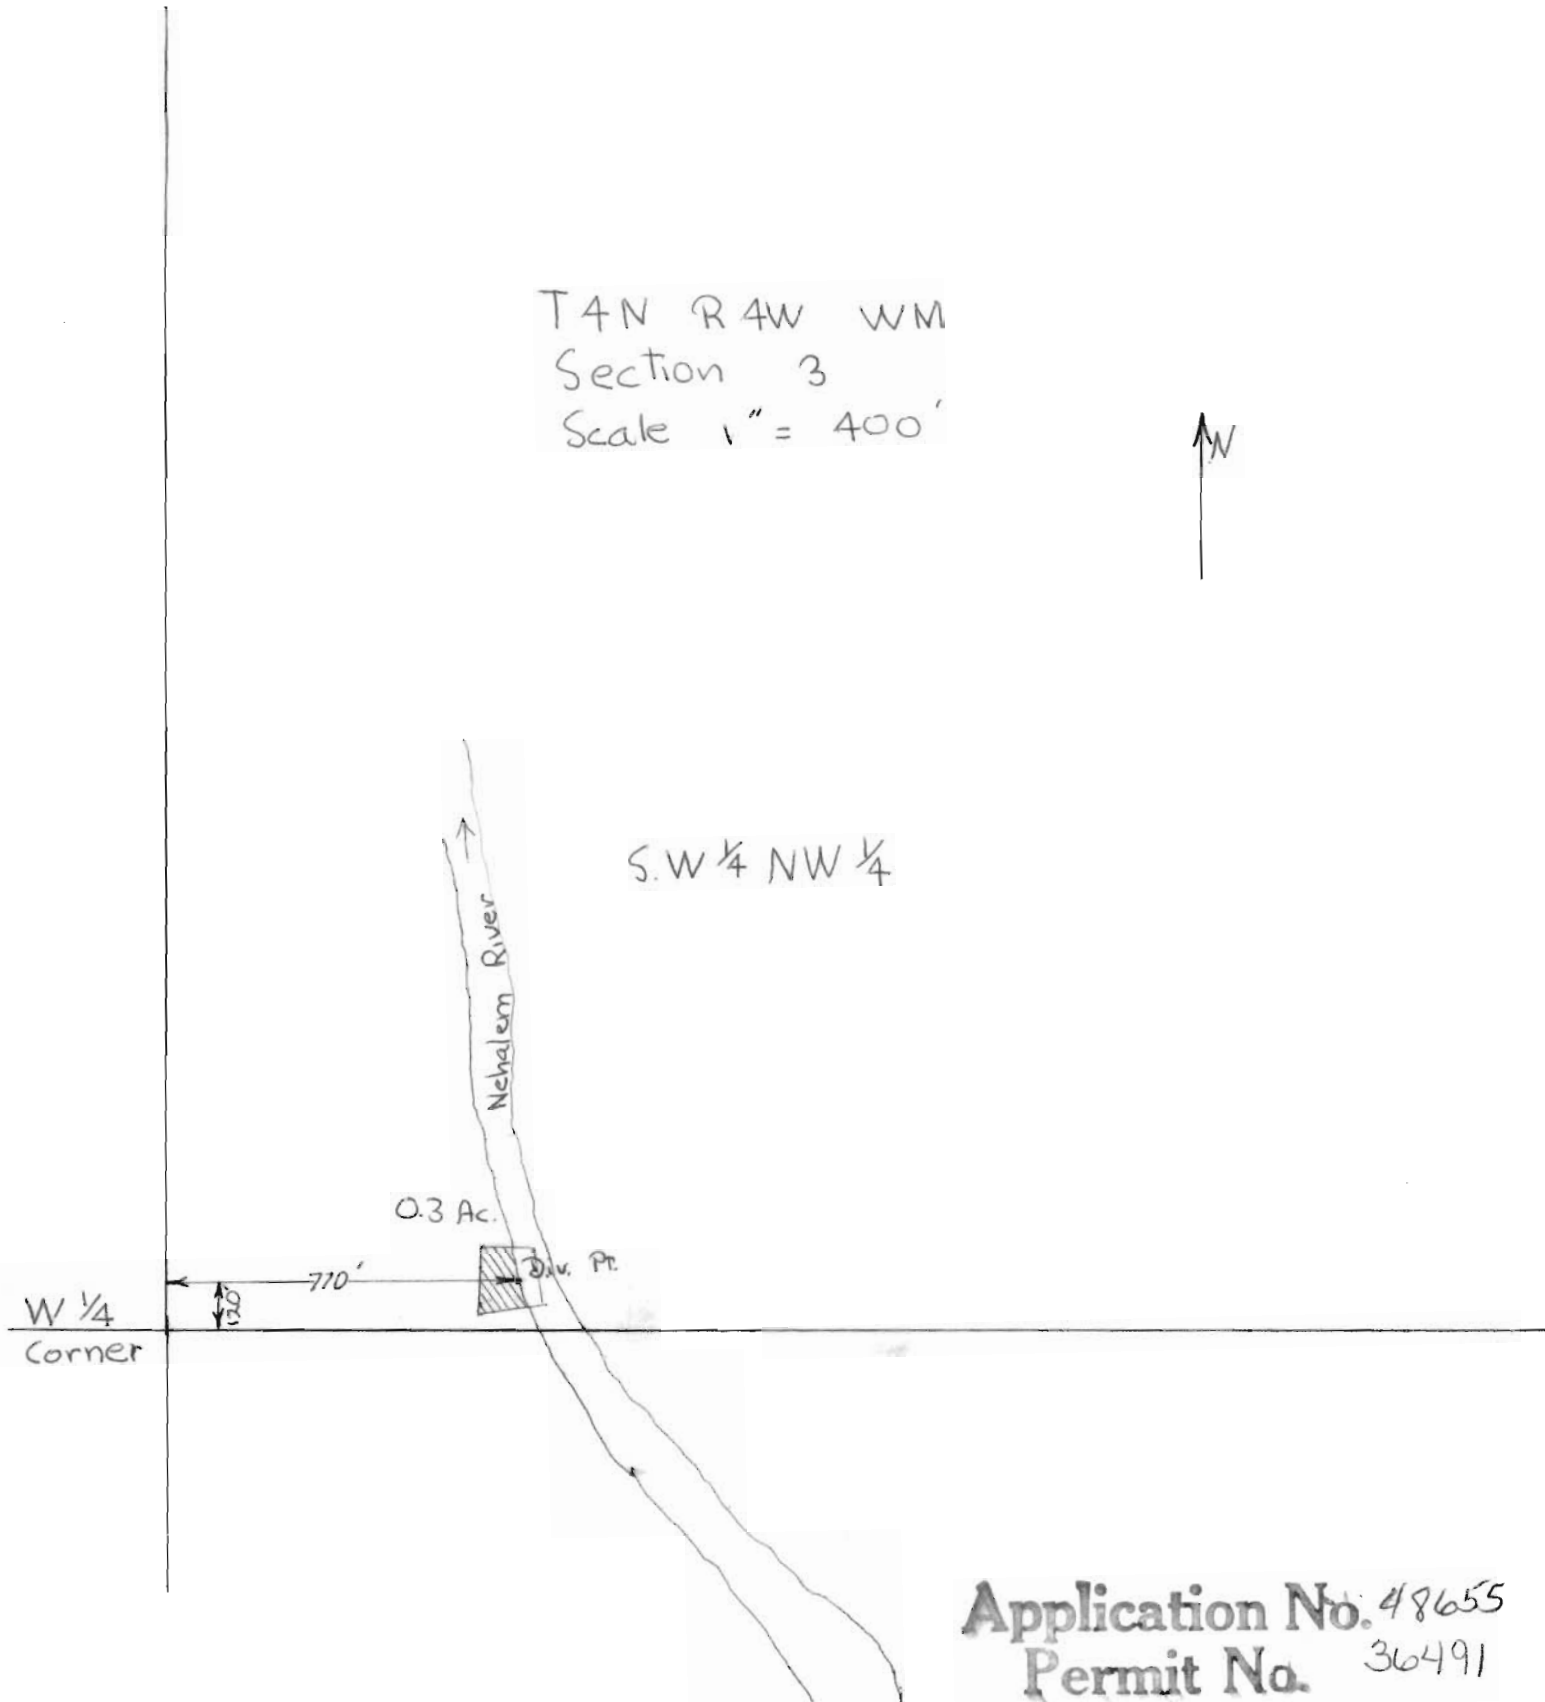

Application No. 48655
Permit No. 36491