

36553


37-7-1

T.37S. R.7W. W.M.

RECEIVED

NOV 24 1976

WM. DIST. 14
GRANTS PASS, ORE.

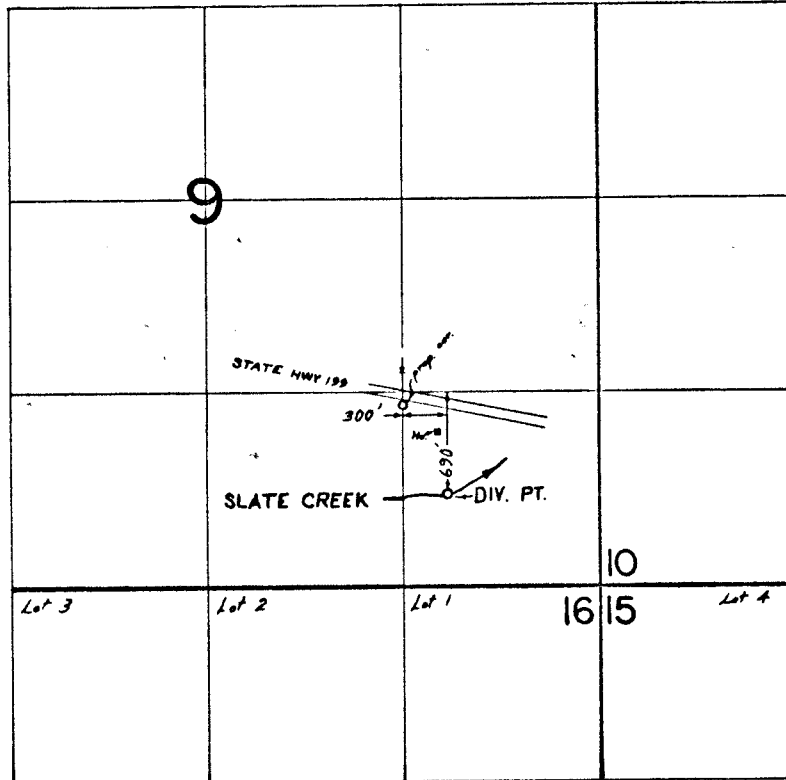

FINAL PROOF SURVEY
UNDER

Application No. 48728 Permit No. 36553
IN NAME OF

ALLEN B. STEDMAN

Surveyed MAY 21, 1974, by L. E. GOULD