


T. 37 S., R. 6 W., W.M.

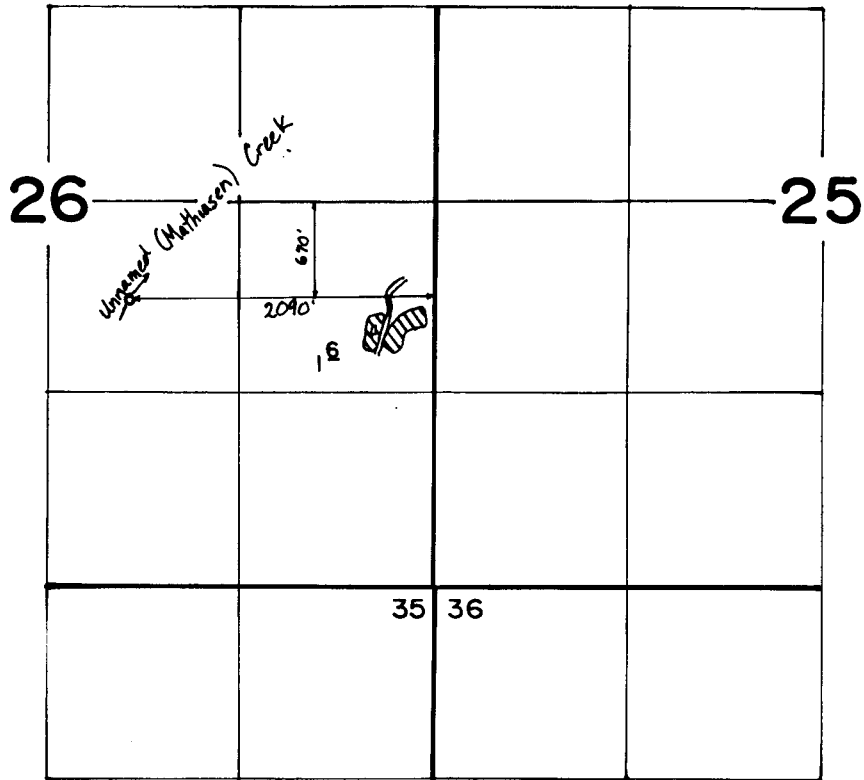

RECORDED

MAY 19 1987

W.M. DIST. 14
GRANTS PASS, OR.

FINAL PROOF SURVEY
UNDER

Application No. 48741 Permit No. 36558
IN NAME OF

FRED W. SILER

Surveyed JUNE 17, 1982, by B. R. SUND