


T. 38 S., R. 8 W., W.M.

RECEIVED

JAN 23 1979

WM. DIST. 14
GRANTS PASS, ORE

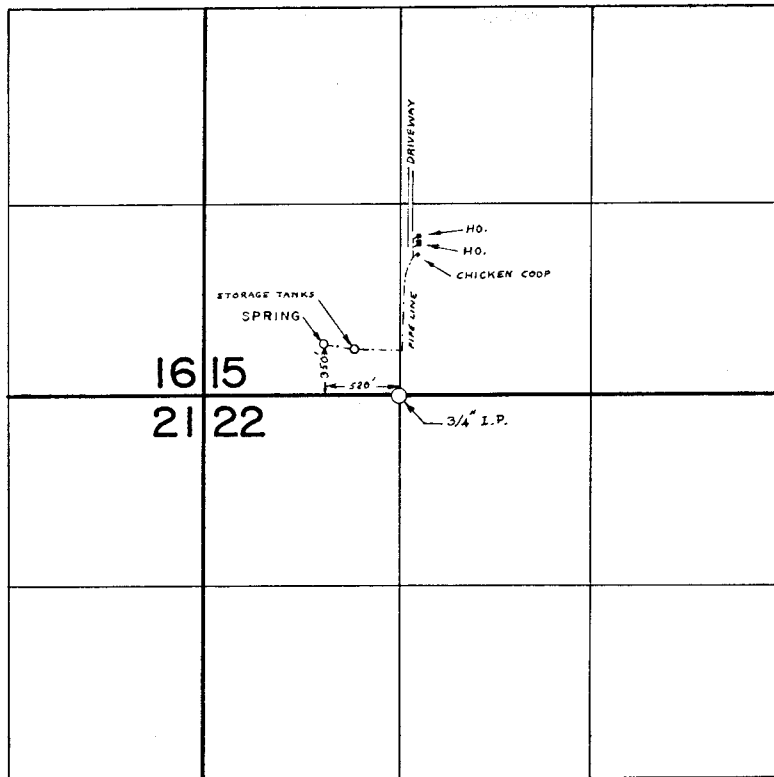

FINAL PROOF SURVEY
UNDER

Application No. 48833 Permit No. 36598
IN NAME OF

VINCENT D. BEAN

Surveyed NOV. 10. 1977, by B. SUND

PTS 1977-14-B

TAX LOT: 1207