



T13S., R31E.W.M.

RECEIVED
NOV 23 1971
STATE ENGINEER
SALEM, OREGON

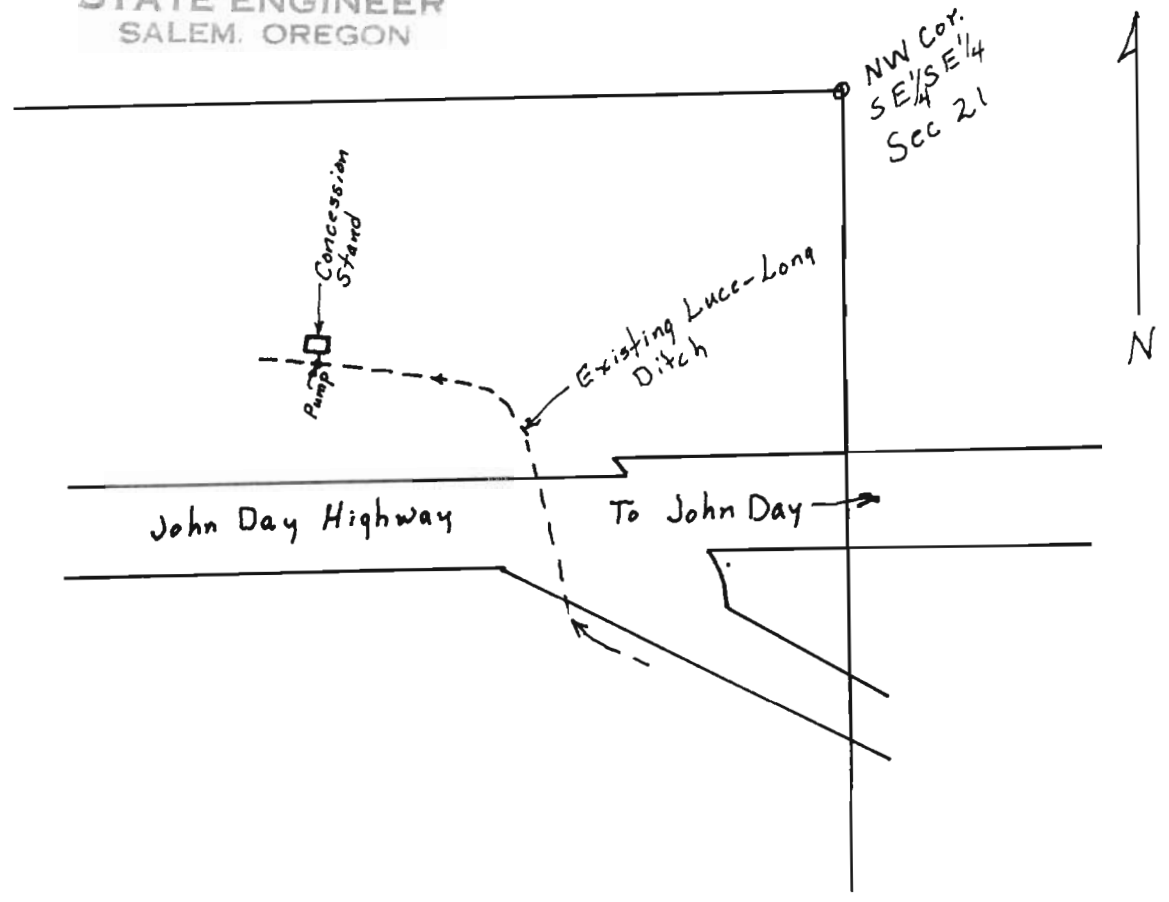

Scale: 1" = 200'

Map approved by: B. C. Holland

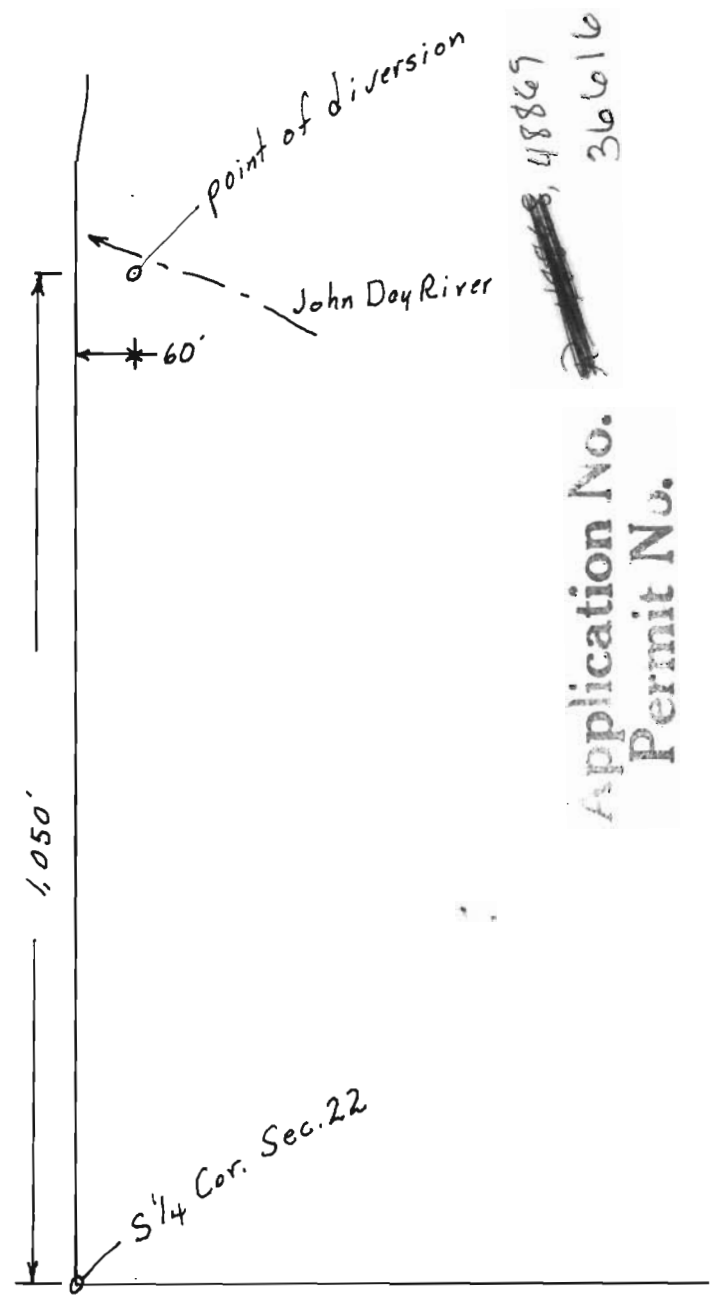

Application No. 48869
Permit No. 36616