

R-5939
36630


T.33&34S.R.6W.W.M.

RECEIVED

NOV 21 1976

WM. DIST. 14
GRANTS PASS, GRE

34-5-7

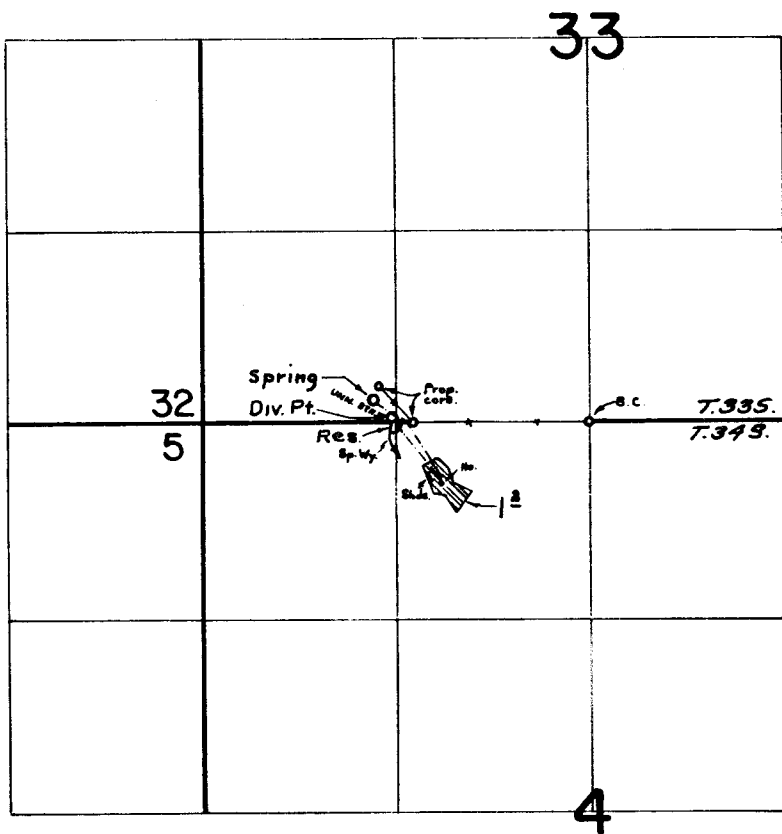

Spring located 150' N & 1470' W, Div Pt. from Unn. Str located 30' N. & 1350' W.
both from S. 1/4 cor. Sec. 33

FINAL PROOF SURVEY UNDER

Application No. 48900 Permit No. 36630
R-49047 R-5939
IN NAME OF

LESLIE G. & VERA L. ESPE

Surveyed MAY 24, 1974, by L. E. GOULD

P.T.S. 1974-K *SAF*