


T. 39 S., R. 8 W., W.M.

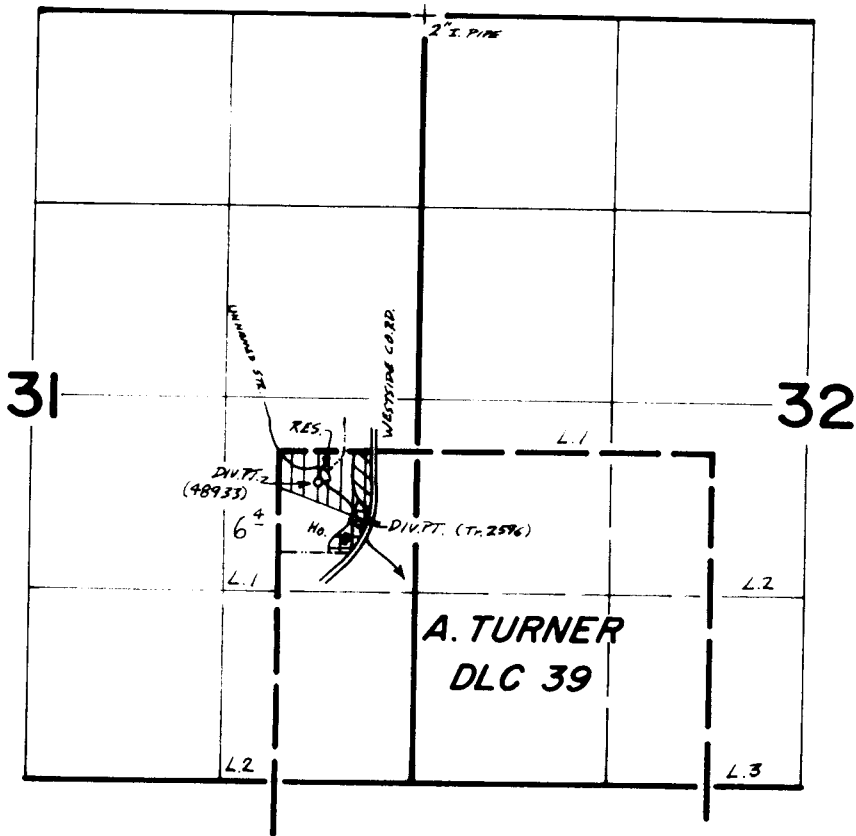

RECEIVED

AUG 29 1985

WM. DIST. 14
GRANTS PASS, ORE



Scale: 4" = 1 mile

- Cert. 45765 = 1¹⁷/₂ ac.
- Tr.No. 2596 = 1¹/₂ ac.
- 48933 = primary 4¹³/₂
(36643) suppl. 227

FINAL PROOF SURVEY

UNDER

Transfer No. 2596

R-48932 R-5936

Application No. 48933 Permit No. 36643

IN NAME OF

CARL B. JACOBSON

Surveyed May 1, 1980, by B.R. SUND

PT3-1180-11A 4+033-14-21+