


T. 34 S., R. 7 W., W.M.

RECEIVED  
MAY 29 1979

WM. DIST. 14  
GRANTS PASS, ORE.

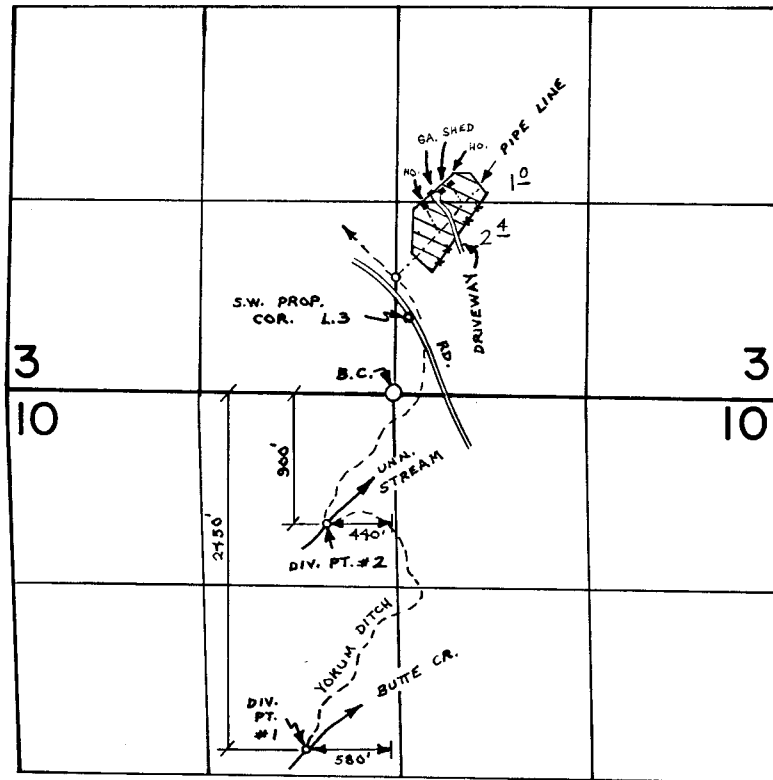

**FINAL PROOF SURVEY  
UNDER**

Application No. 48936 Permit No. 36644  
IN NAME OF

JASPER LOY YOKUM

Surveyed OCT. 11 77 by B. SUND

*Cost 477.00*

D.H.M.  
PTS 1077-14 B