




T.18S.R.10W.W.M.

Application No. 48988
Permit No. 36676

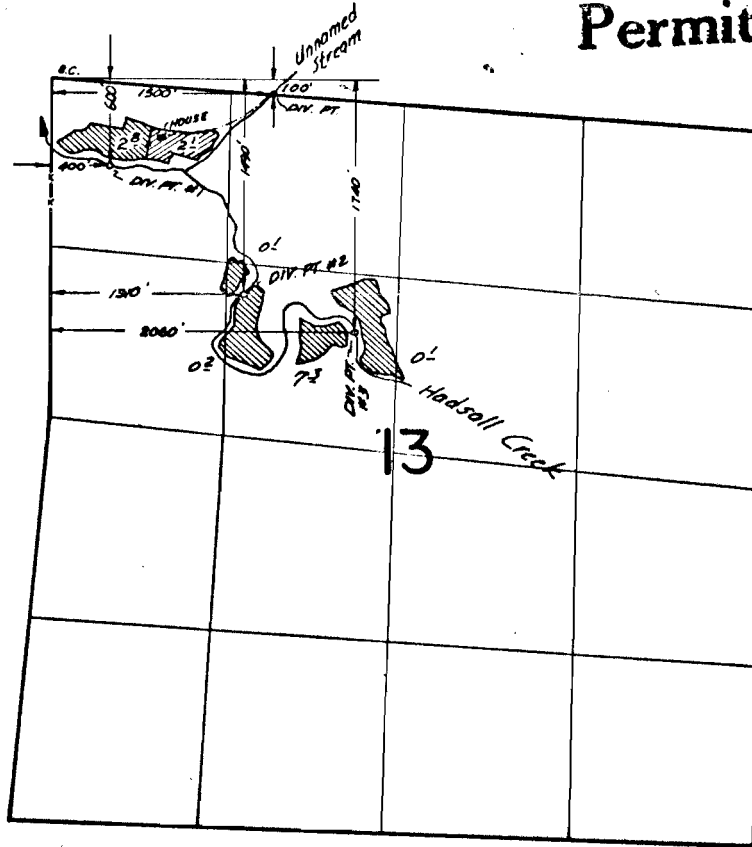

 from unnamed stream
 from Hadsall Creek

RECORDED
INDEXED
STATE ENGINEER
SALEM OREGON

FINAL PROOF SURVEY
UNDER

Application No. 38292 Permit No. 28523
IN NAME OF

IVAN W. & IONE REED

Surveyed March 24 1970, by V.P. Garner

copy