

T. 13 S., R. 31 E. W.M.

PROPHET ADDITION

CANYON CITY


GRANT COUNTY, OREGON

SCALE: 1 inch equals 100 ft.




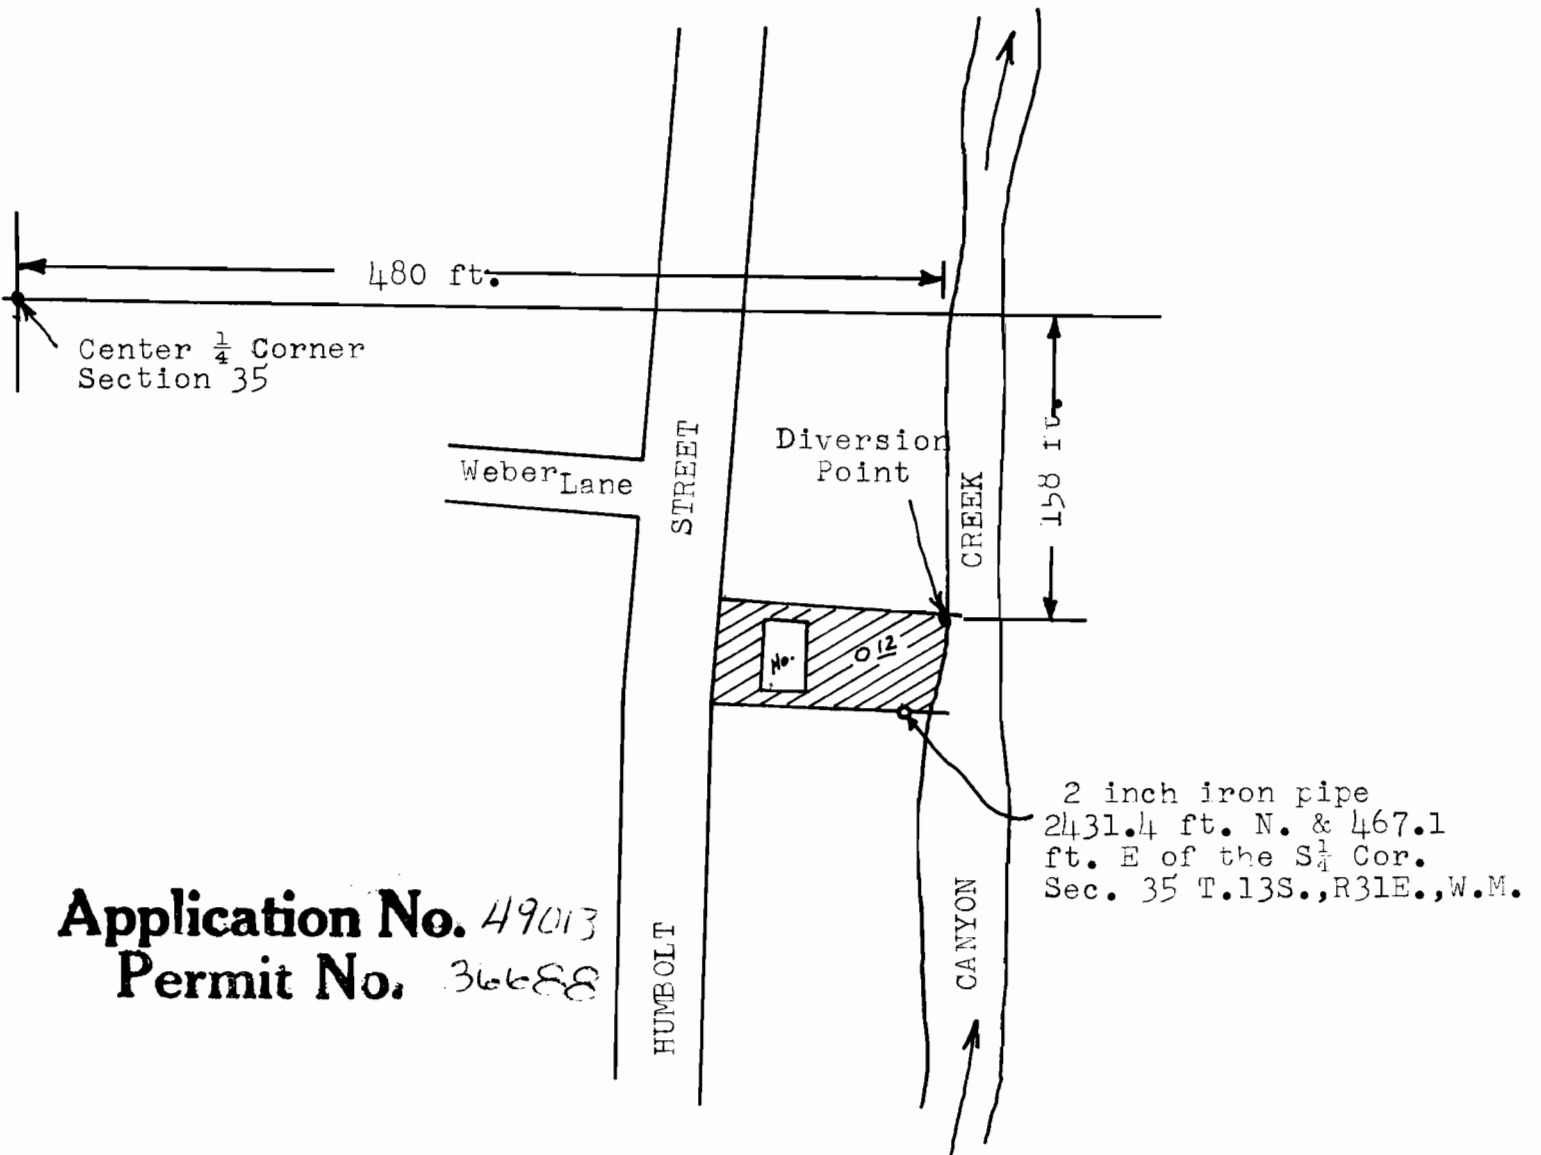

Application No. 49013  
Permit No. 36688