


RECEIVED
APR 8 1973
STATE ENGINEER
SALEM, OREGON

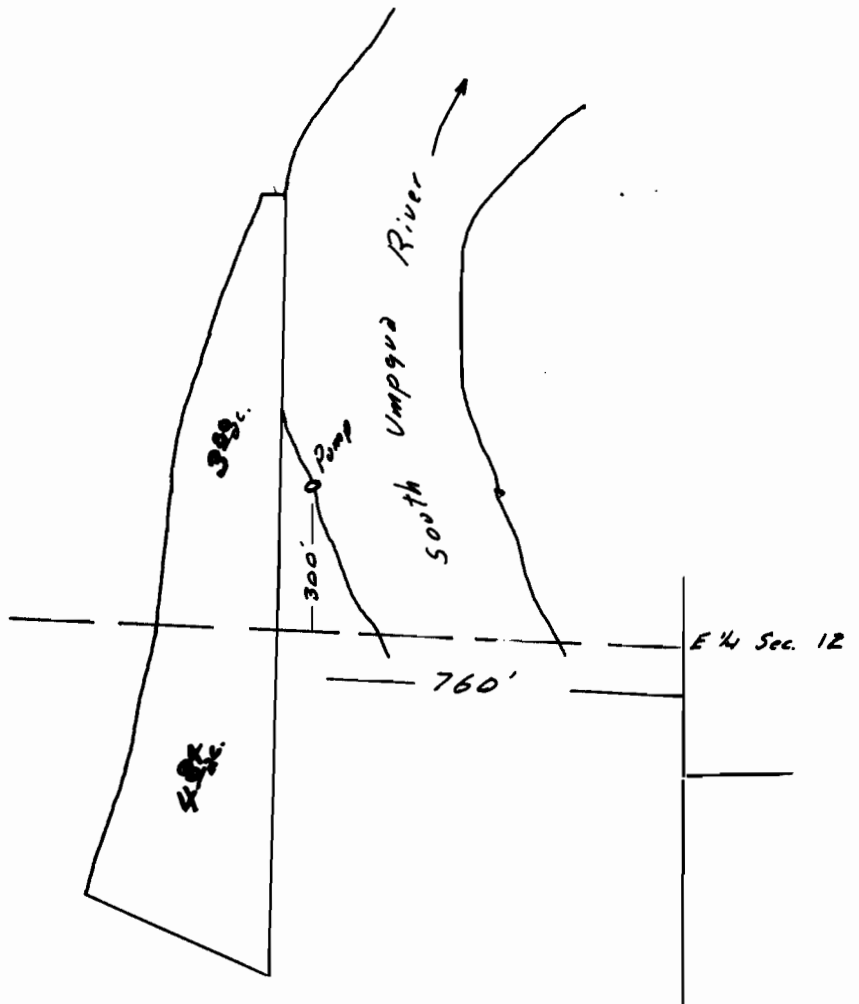

TP. 30 So., R6 W.W.M.
1" = 400'

3.80
+ 4.84

8.64 ac.

Application No. 20271
Permit No. 36710