


RECEIVED
MAY 11 1972
STATE ENGINEER
SALEM OREGON

RECEIVED
MAY 11 1972
STATE ENGINEER
SALEM OREGON

T.305 R2W Sec 22
Scale 1" = 400'

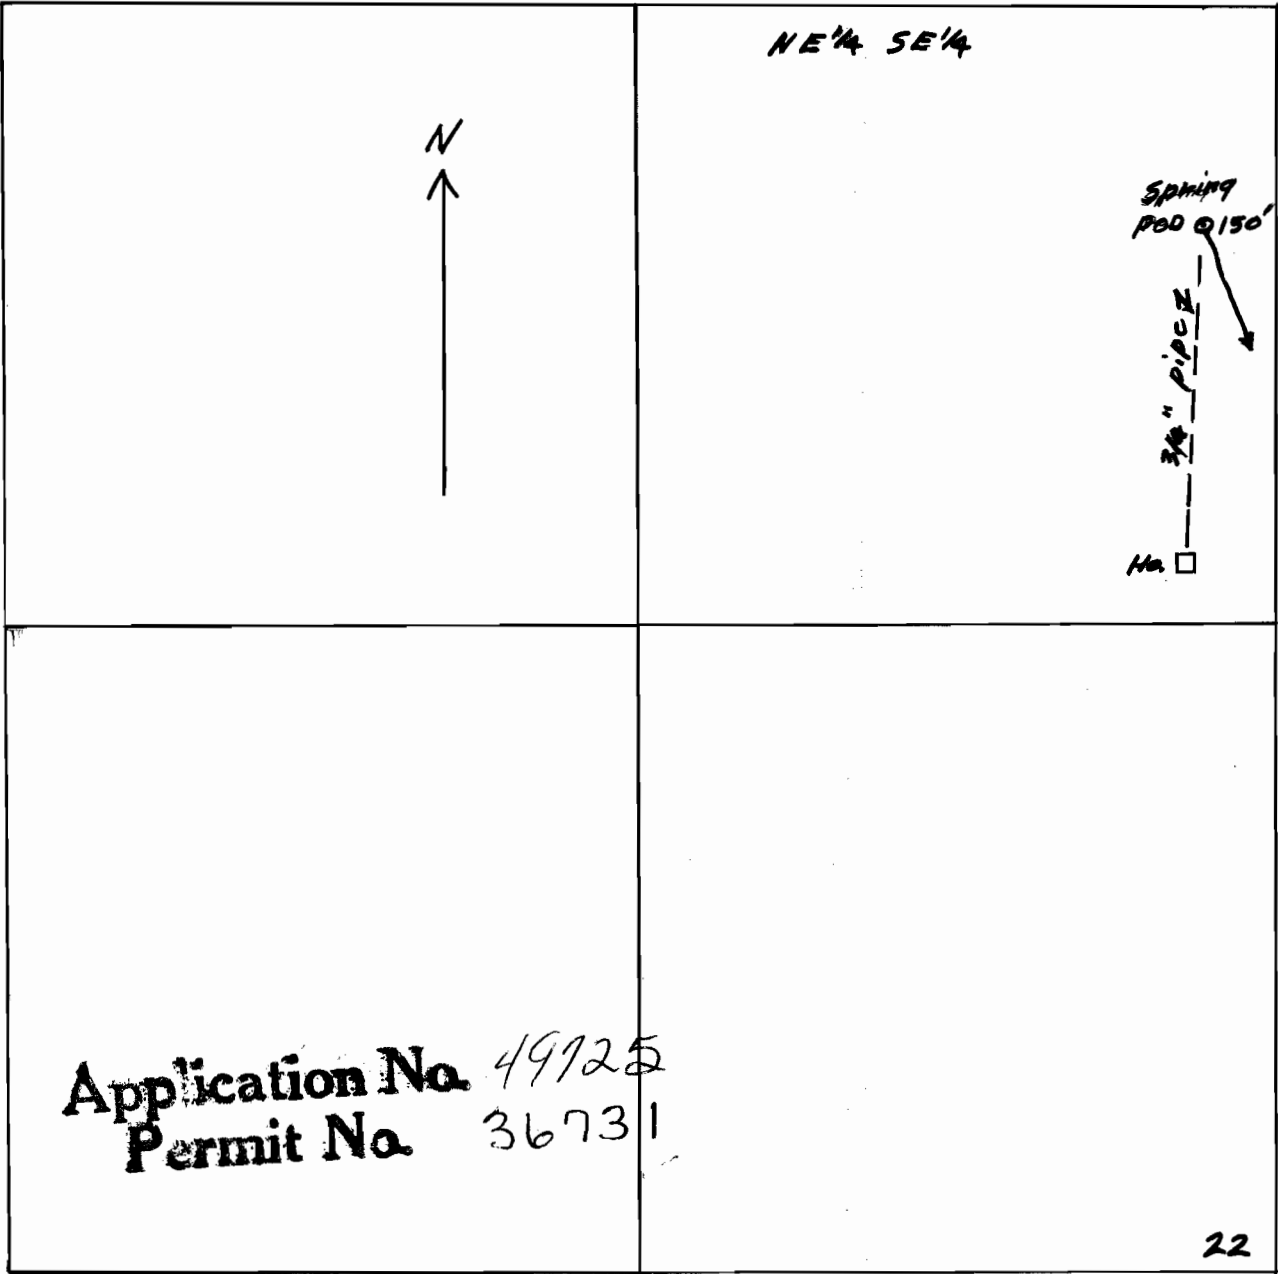

Application No. 49725
Permit No. 36731

2180 N.

22 23
27 26