


T.4N. R.3W. W.M.

**RECEIVED**  
AUG 2 1972  
STATE ENGINEER  
CLATSOP COUNTY

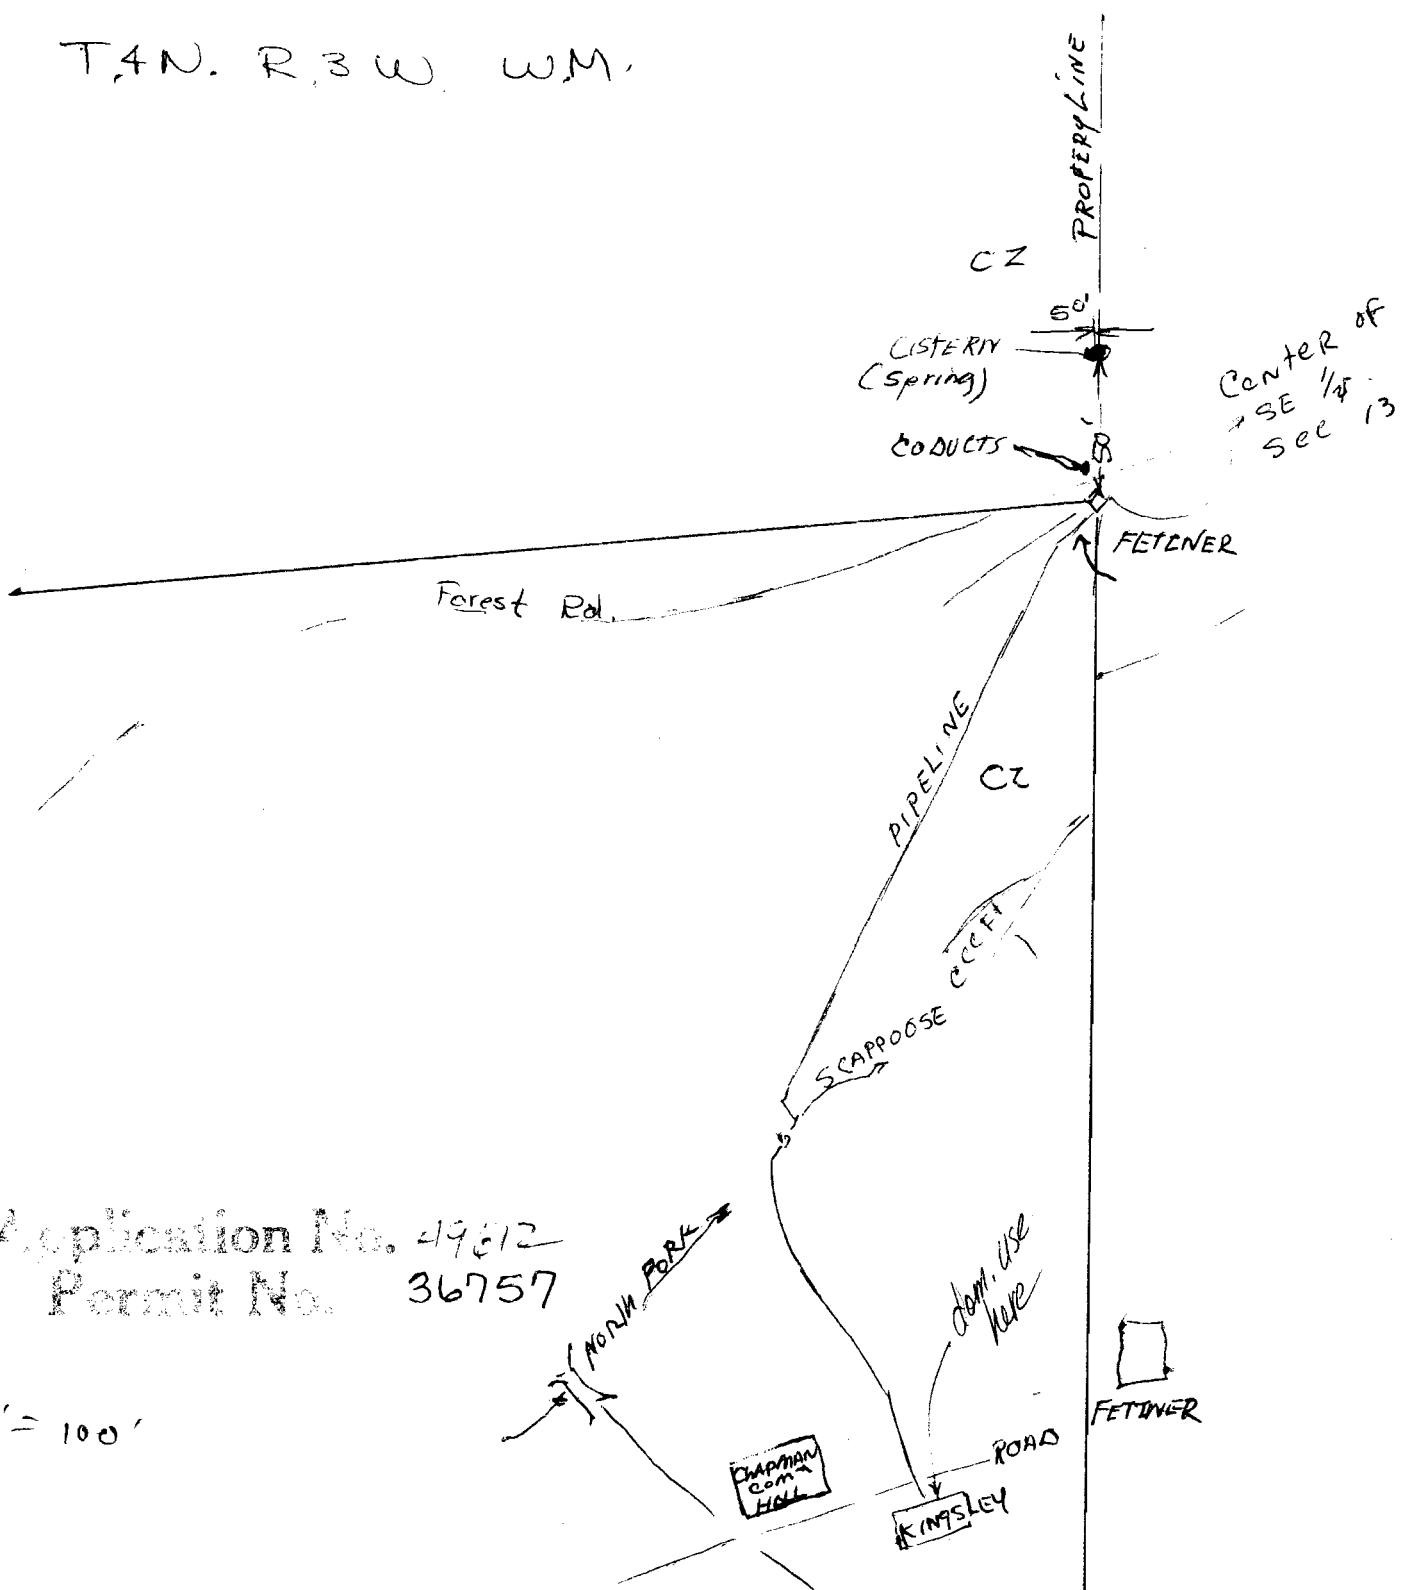

Nicholson

Application No. 49512  
Permit No. 36757

Scale 1" = 100'