


RECEIVED

T.37 S., R.7 W., W.M.

JAN 4 1985

SEC. 2

WM. DIST. 54
GRANTS PASS, ORE.

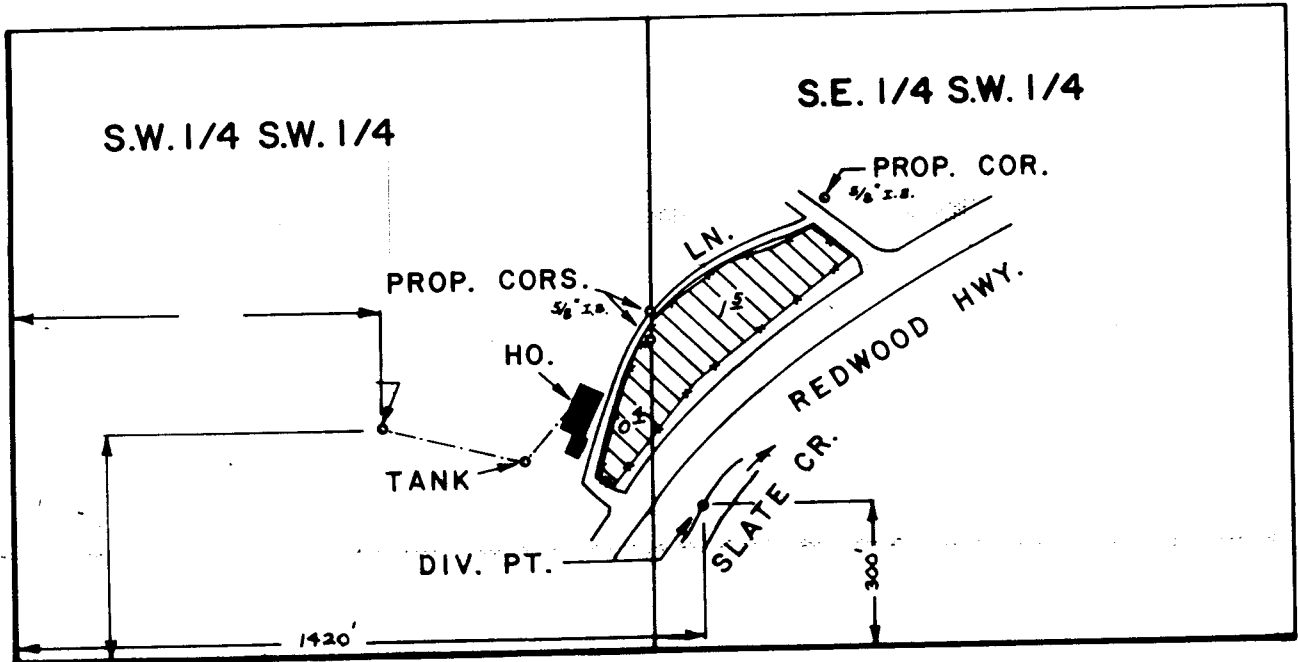

SCALE: 1" = 400 FT.

FINAL PROOF SURVEY
UNDER

Application No. 49551 Permit No. 36775
IN NAME OF

C-58611

..... WILLIAM J. E. CARL L. HICKS
Surveyed APR. 12 1979 by B. SUND

D.H.M.
P.T.S. - 1979-14-A