


T. 37 S., R. 9 W., W.M.

RECEIVED

APR 8 1986

WM. DIST. 14
GRANTS MASS. ORF

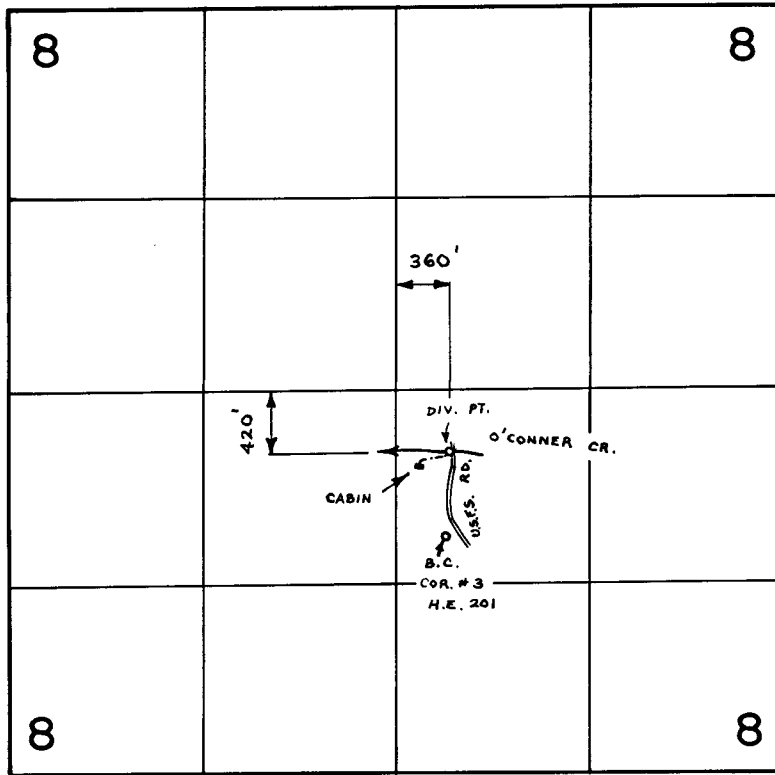

FINAL PROOF SURVEY
UNDER

Application No. 49645 Permit No. 36786
IN NAME OF

J. ROBERT EGAN

Surveyed AUG. 23 1978, by B. SUND


D.H.M.
P.T.S.-1978-14-C

T. 37 S., R. 9 W., W.M.

RECEIVED

APR 8 1986

WM. DIST. 14
GRANTS PASS, ORE.

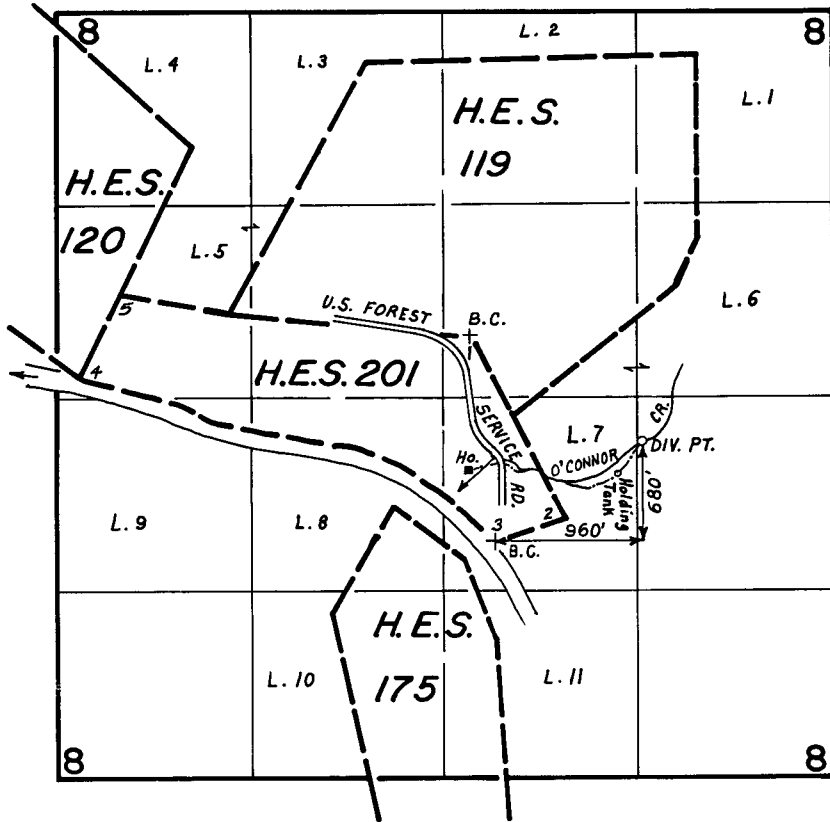

SCALE: 1" = 1320'

FINAL PROOF SURVEY

UNDER

TRANSFER NO. 4924

Application No. Permit No.
IN NAME OF

J. ROBERT EGAN

Surveyed MAR. 2 1984, by B. S. JAMES