

CS 1/16

OSFB Brass Cap

103.73'

S. 88°58'48" E.

438.01'

NW<sup>4</sup> SE<sup>4</sup>

3/4" line  
S. 20°05'36" W


S. 88°58'48" E.

S 1/16

NE cor. of S<sup>2</sup>SE<sup>4</sup>  
section 36

N. 0.00  
W.0.00

OSFB Brass Cap

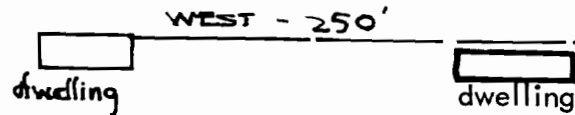

**RECEIVED**  
MAY 7 1972  
STATE ENGINEER  
SALEM, OREGON.

TRANSIT & TAPE SURVEY MAP  
for

NANCY NIXON

WATER RIGHT  
in

Section 36, T. 1 S., R. 9 W., W.M.

February, 1972

SCALE 1" = 100 FEET

meridian TRUE from tie to  
OSFB solar observation

N. 3°19' E.

573.47'

6.75 acre tract

631.88'

S. 3°19' W.

Radius = 2834.79'

**Application No.** 49173  
**Permit No.** 36862

REGISTERED  
**OREGON**  
LAND SURVEYOR

MAY 9, 1952  
JOHN L. CARLICH  
287

**RECEIVED**  
MAY 9 1972  
STATE ENGINEER  
SALEM, OREGON

Point of Beginning  
S. 534.29 feet &  
W. 2193.30 feet of  
NE cor. S<sup>2</sup>SE<sup>4</sup>, sec. 36

473.69'

N. 82°07'20" W.

a = 15.48'  
chord = 15.48' @  
N. 82°16'43" W.

TRASK RIVER COUNTY ROAD  
apparent Northerly sideline of road