


OLD WILSON RIVER ROAD

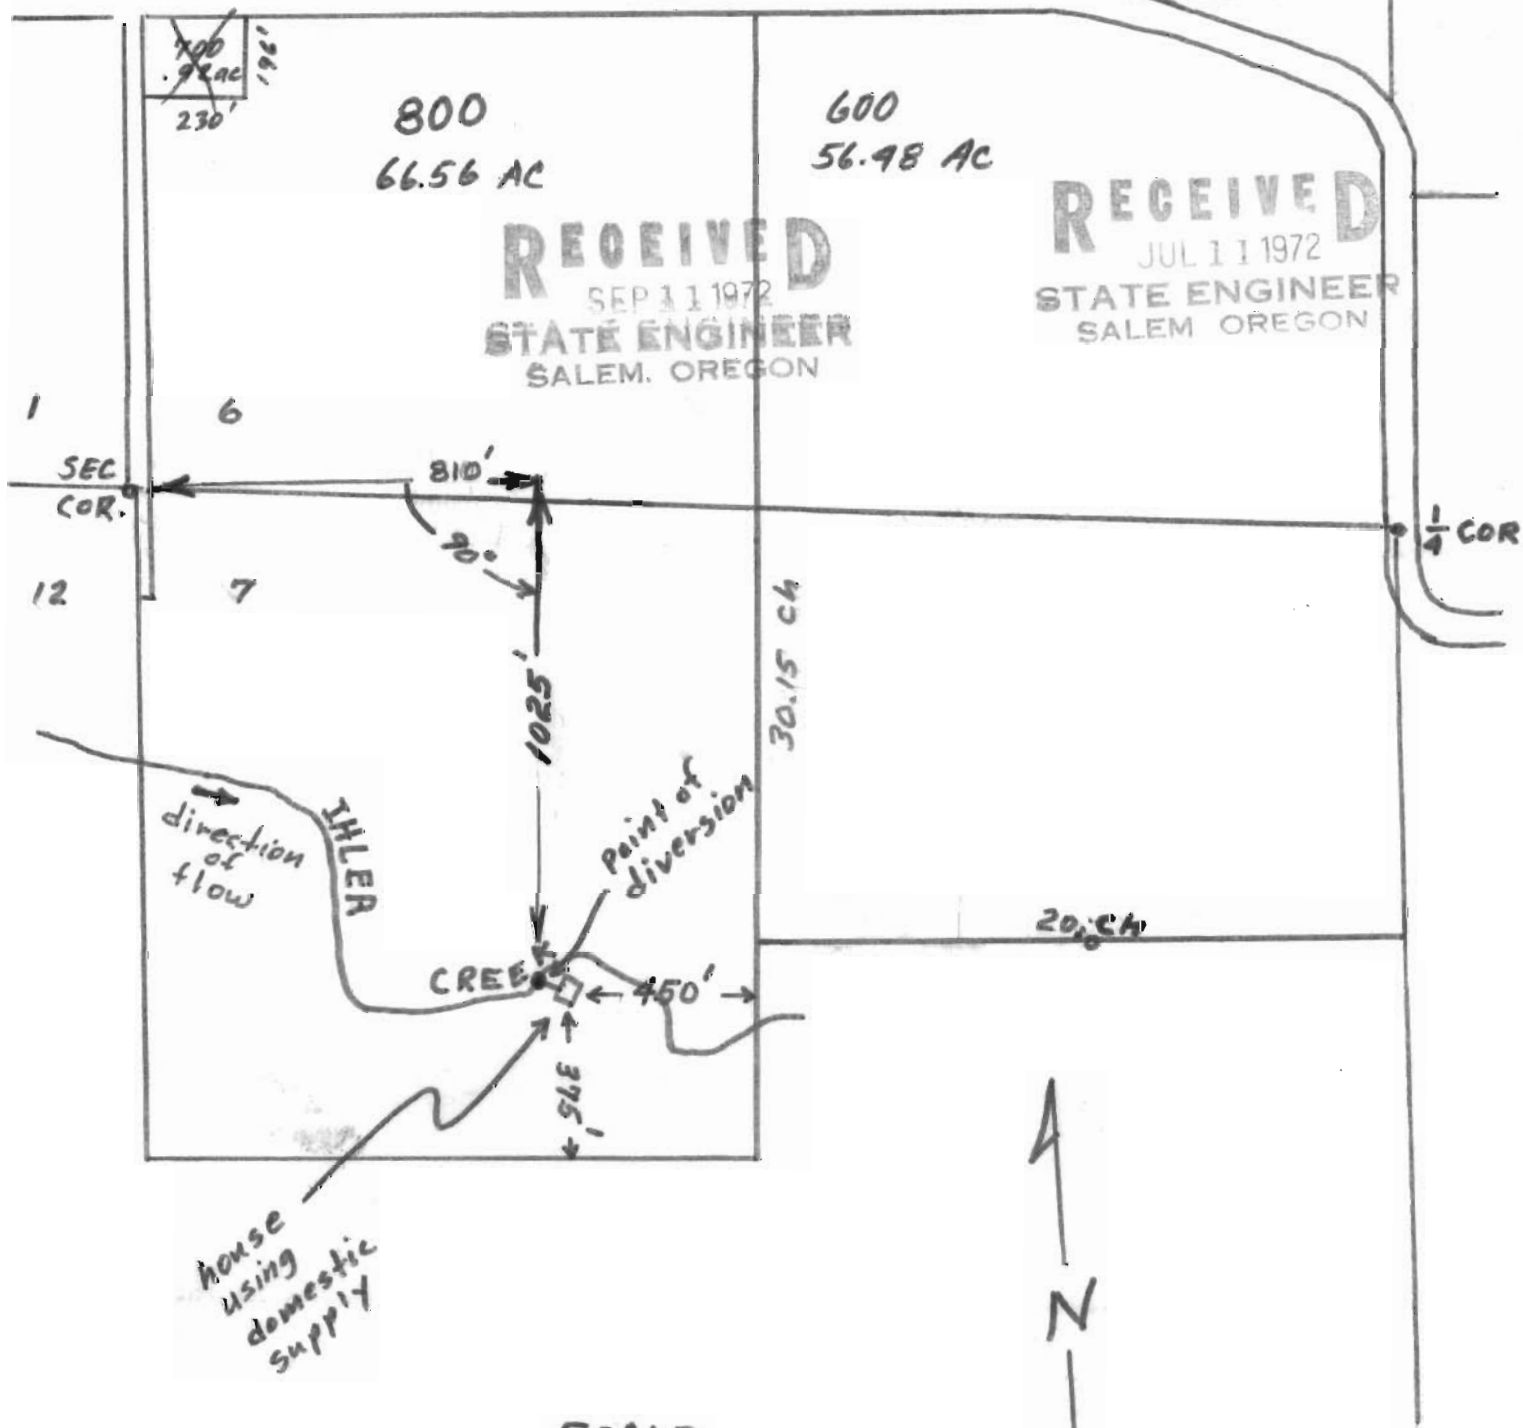

house using domestic supply

SCALE  
1" = 400'

Application No. 49435  
Permit No. 37036

Description of Property

The N.W.  $\frac{1}{4}$  of the N.W.  $\frac{1}{4}$  of Sec. 7, T1N, R4W of the Willamette meridian, Washington county, Ore. and the S.W.  $\frac{1}{4}$  of S.W.  $\frac{1}{4}$  of sec 6, T1N, R4W of the Willamette meridian, Washington County, Ore.